


Section 9 Township 33 Range 12W

Well No. #2 Boggs Est.

Company Magnolia
Boggs Pool

14

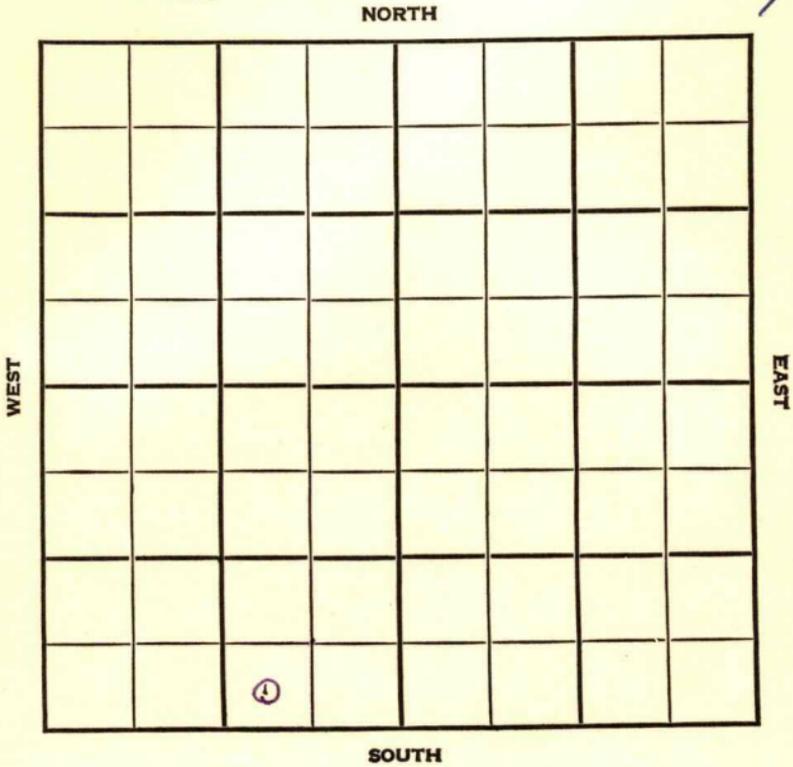

Sec. 9 **KANSAS** Twp. 33 R. 12W

Well No. #2 Boggs Est. Farm

Magnolia Company

Boggs Pool


Ft. from N. Line

330 Ft. from S. Line

990 Ft. from E. Line

Ft. from W. Line

SW SE SW

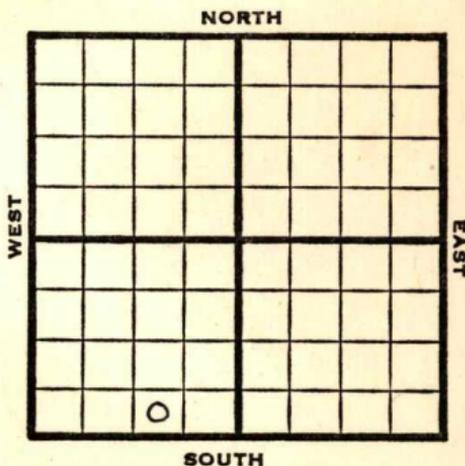

1948

Eli 1503'

REPORT

4/21 Location

4/28 Surface hole.

5/5 8" @ 1640'
Drlg. 2165'

5/12 Drlg. 3560'

5/19 Drlg. 4385'

5/26 **Simpson 4842'**
Drlg. 4868'

6/1 TD 4897' Run. 5"

6/9 5" @ 4846'

6/16 TD 4893'
Simp 4838
5" @ 4846'
Pump 60 Pot
41⁰ Gr.
Comp

COMPLETED

Map No. _____ Sec. 9 Twp. 33 R. 12W

Well No. 2 Boggs Est.


Magnolia _____ Company

1ST REPORT

Contractor

SW SE SW

SECTION PLAT

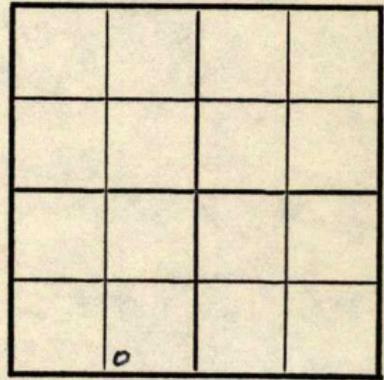

_____ Ft. from N. Line

330 Ft. from S. Line

990 Ft. from E. Line

_____ Ft. from W. Line

Barber County

Location X

Rig up _____

Drilling and Remarks:

RECORD

Cased _____ in., _____ ft.

Sand _____

Gas _____

Oil _____

Total Depth _____

PRODUCTION

1st 24 hrs. Nat. _____

1st 24 hrs. after shot _____

Gas _____ Cu. Ft.

Dry Hole _____

Abandoned _____

Date

APR 21 1948 19

S. J. LEWIS Scout

