

Barber KANSAS


Barber

KANSAS

Section 18 Township 33 Range 12 W
Well No. # 1 Alexander "B"
Company Skelly Oil

Well No. # 1 Alexander "B"

Company Skelly Oil

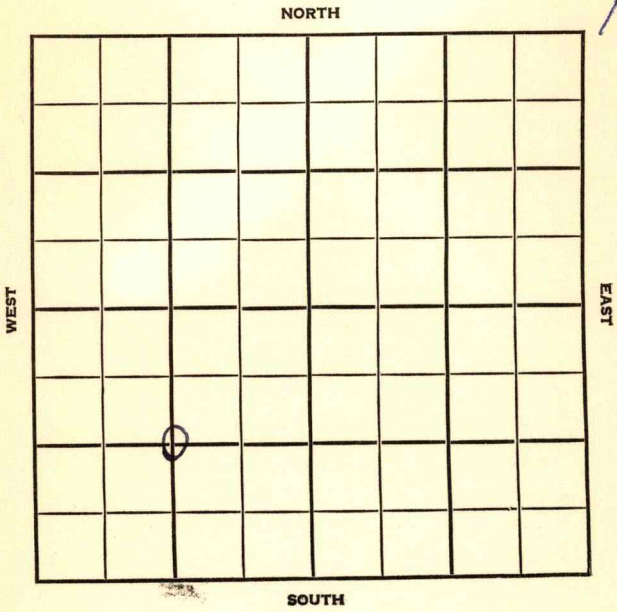

SEC. 18 7	TWP. 33	R. 12W
WELL NO. #1 Alexander "B"		
COMPANY Skelly Oil		FARM
CONTRACTOR		

	Ft. from N. Line	NORTH SOUTH
1320	Ft. from S. Line	
	Ft. from E. Line	
1320	Ft. from W. Line	

C SW/4

	ELEVATION	REPORT
1955	1647'	
1/12	Location	
3/23	Spud 1-14-55, gas well, TD 4585 8" @ 476, Elgin 3670, Heeb 3795 Tor 3803, DST 3786-3850, open 1 hr gas in 27 min. 250,000 CFG 105' GCM 1485#, Tong sd 3898, Lans 3963, DST 3867-3965, open 1 hr, gas in 12 min 1250' HGCM SW 1190# B KC 4439, Marm 4449 Miss 4498, DST 4479-4550, open 65 min. gas in 9 min, 170,000 CFG 50' mud 1600#, TD 4585, 5" @ 4585 CO to 4556, 124/ 4518-42 500 A viso-frac 2,190,000 CFG PB 4514 48/3505-13, 45/4498-4505, 1,630,000 CFG visco-frac 2,300,000 R CFG Comp 3,288,000 CFGPD	

COMPLETED

County Barber State Kansas

Sec. 18 (Blk. Twp.) 33 (Sur. Rge.) 12W Map No.

Operator Skelly Oil

Well No. **1** Farm **Alexander "B"**

Elev.	Location	C SW/4
-------	----------	--------

FIRST REPORT

1320 Ft. From S Line SW

1320 Ft. From W Line Quarter

1st. Report JAN 12 1955

Completion

[illegible]

Spudding Date _____

Drlg. Data

Location

FABEN G'LTRAP

County Barber State Kansas
 Sec. 7 (Blk. 33 (Sur. 12W Map No.
 Twp.) Rge.)
 Operator Skelly Oil
 Well No. 1 Farm Alexander "B"
 Elev. 1647 Location C SW/4



1395 Ft. From S Line SW
1295 Ft. From W Line Quarter
 1st. Report
 Completion MAR 23 1955
 Remarks
Hulme Drlg. - Contr.
 Spudding Date 1-14-55

Drlg. Data Gas well TD 4585
8" @ 476 Elgin 3670 Heeb. 3795
Tor. 3803 DST 3786-3850 open 1hr.
gas in 27 min. 250,000 cfg 105' gcm
1485# Tong. sd. 3898 Lans. 3963
DST 3867-3965 open 1 hr. gas in 12 min.
1250' hgcmw 1190# B KC 4439
Marm. 4449 Miss. 4498 DST 4479-4550
open 65 min. gas in 9 min. 170,000 cfg
50' mud 1600# TD 4585 5" @ 4585
CO to 4556 124/ 4518-42 500 A
visco-frac 2,190,000 cfg PB 4514
48/ 4505-13 45/ 4498-4505
1,630,000 cfg visco-frac 2,300,000 cfg
Comp. 3,288,000 cfcpd

FABEN GILSTRAP

SCOUT TICKET

DX-201

Kansas

SEC.

7

TWP.

33

R.

12W

WELL NO.

1 Alexander "B"

FARM

COMPANY

Skelly Oil

CONTRACTOR

C SW/4

____ FT. FROM N. LINE


1395

____ FT. FROM S. LINE

____ FT. FORM E. LINE

1295

____ FT. FROM W. LINE

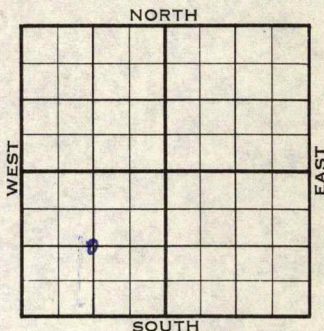

Barber County

☐

LOCATION

☐

RIG UP

DRILLING AND REMARKS:

Reported
18-33-12W

RECORD

CASED IN., FT.

SAND

GAS

OIL

TOTAL DEPTH

1ST 24 HRS. NAT.

1ST 24 HRS. AFTER SHOT

GAS

CU. FT.

DRY HOLE

ABANDONED

PRODUCTION

DATE 19 1955

SCOUT

FABEN GILSTRAP