

KANSAS

Barber


Section 8 Township 33 Range 12WWell No. 1 Alexandere- BoggsCompany Skelly & C S O

Boggs Pool

NORTH

WEST


EAST

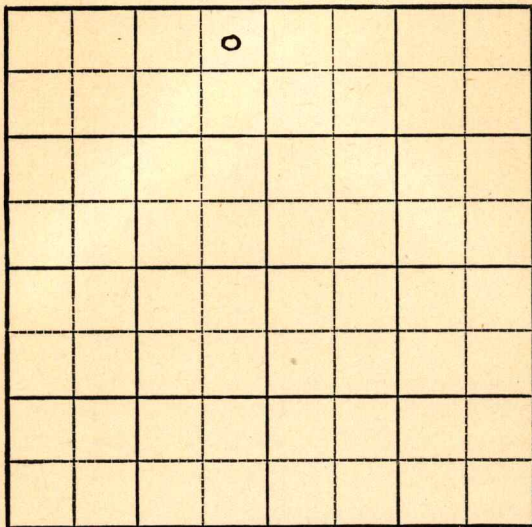

SOUTH

Sec. 8 **KANSAS** Twp. 33 R. 12W
Well No. #1 Alexander - Boggs Farm
Skelly & C S O Company

330' Ft. from N. Line
 Ft. from S. Line
390' Ft. from E. Line
 Ft. from W. Line

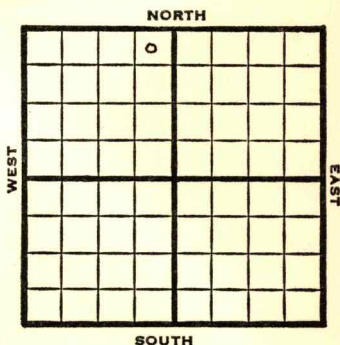

NE NW

1948 **Elev 1560'** REPORT

12/8	Location
12/14	"
12/22	8" @ 455' Drlg. 1277'
12/29	Drlg. 3130'
1/5	Douglas 3742-46' TD 3746' 5" @ 3746' 6 M Gas
1/12	TD 3775-12,800,000 gas 1250# RPR
1/19	"
1/26	"
2/2	"
2/9	"
2/16	"
2/23	TD 3775' Douglas 3742' 5" @ 3746' 12,800,000 Gas 1250# R Pr. Comp COMPLETED

Map No. _____ Sec. 8 Twp. 33 R. 12W

Well No. 1 Alexander - Boggs

Skelly & C S O Company

FIRST REPORT Contractor

NE NW

SECTION PLAT

330 Ft. from N. Line

_____ Ft. from S. Line

390 Ft. from E. Line

_____ Ft. from W. Line

Barber County

Location X

Rig up _____

Drilling and Remarks:

RECORD

Cased _____ in., _____ ft.

Sand _____

Gas _____

Oil _____

Total Depth _____

PRODUCTION

1st 24 hrs. Nat. _____

1st 24 hrs. after shot _____

Gas _____ Cu. Ft.

Dry Hole _____

Abandoned _____

Date

DEC 8 1948

S. J. LEWIS Scout

Kansas

Boggs Pool

Map No. K61 Sec. 8 Twp. 33 R. 12WWell No. 1 Alexander - BoggsSkelly & CSO CompanyCOMPLETE Contractor

NE NW

E 1, 1560
SECTION PLAT

		0	

330 Ft. from N. Line Ft. from S. Line390 Ft. from E. Line Ft. from W. Line

Barber County

Location Rig up

Drilling and Remarks:

Douglas 37425" 374612, 800, 000 Gas1250' R/L

RECORD

Cased in., ft.Sand Gas Oil Total Depth 3725

PRODUCTION

1st 24 hrs. Nat. 1st 24 hrs. after shot Gas Cu. Ft.Dry Hole Abandoned

Date

FEB 23 1949 19S. J. LEWIS

Scout