


Section 9 Township 33 Range 12W

Well No. #1 Boggs Est.


Company Magnolia

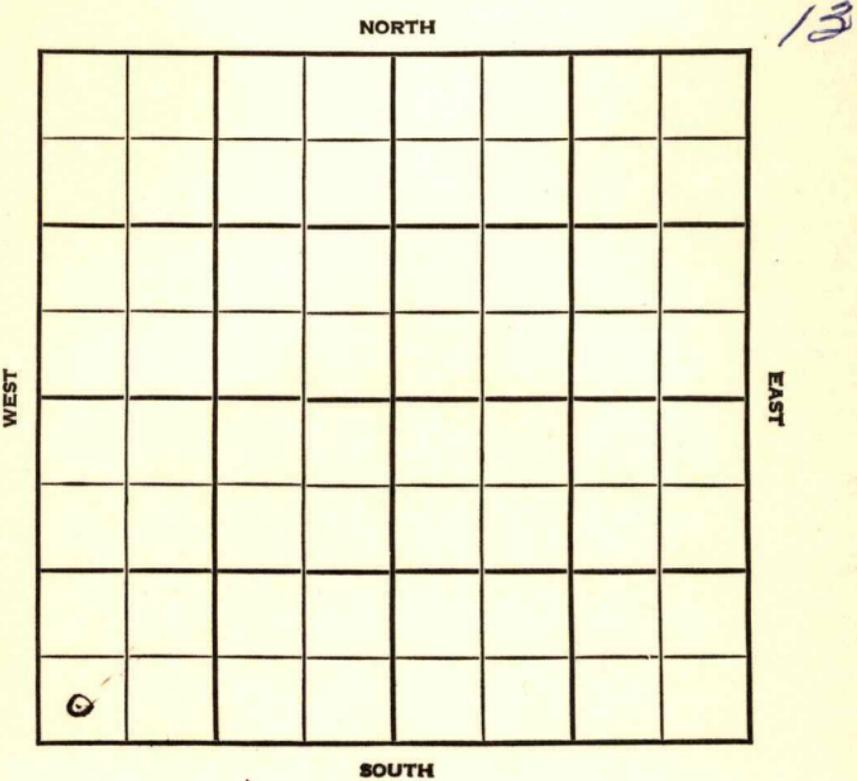

Sec. 9 Twp. 33 R. 12W

Well No. #1 Boggs Est. Farm  
Magnolia Company

Boggs Pool

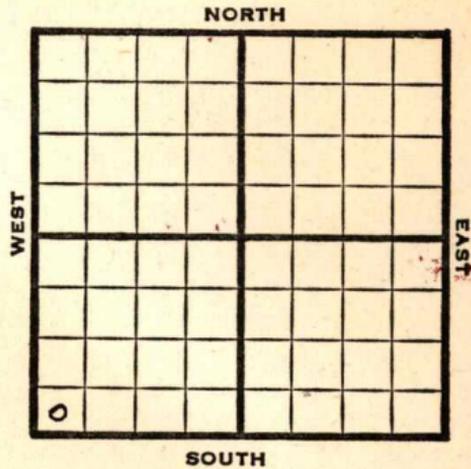

\_\_\_\_\_ Ft. from N. Line

330' \_\_\_\_\_ Ft. from S. Line

\_\_\_\_\_ Ft. from E. Line

330' \_\_\_\_\_ Ft. from W. Line

SW/C

1948 Elev. 1564' REPORT

- 2/4 Location
- 2/11 Surface hole.
- 2/18 Drlg 1310'
- 2/25 8" @ 1694'  
Drlg. 2435'
- 3/3 Drlg. 4005'
- 3/10 Mississippi 4465'  
Drlg. 4610'
- 3/17 Viola 4741'  
Simpson Sand 4863'  
DST 4863-73' TD  
Open 1/2 hr., rec 260' oil / 200,000 gas.  
5" @ 4863'  
RBSST
- 3/24 Flow 34 bbls oil in 4 hrs.
- 3/31 TD 4883'  
Flow 1 1/4 bbls oil PH, 24 hrs.
- 4/7 TD 4891'  
Flow 2 bbls. oil PH 10 hrs.
- 4/14 48 qts 4867-91'  
CO
- 4/21 Flow 2 bbls oil PH  
1,700,000 Gas

1948.

4/28

Simp 4863'

5" @ 4863'

Flow 55 oil Pot.

Gas 1,870,000

Gr. 39.9°

TD 4883'

**COMPLETED**

Map No. \_\_\_\_\_ Sec. 9 Twp. 33 R. 12W

Well No. 1 Boggs Est.

Magnolia Company

FIRST REPORT Contractor

SW/C


SECTION PLAT

\_\_\_\_\_ Ft. from N. Line

330 Ft. from S. Line

\_\_\_\_\_ Ft. from E. Line

330 Ft. from W. Line

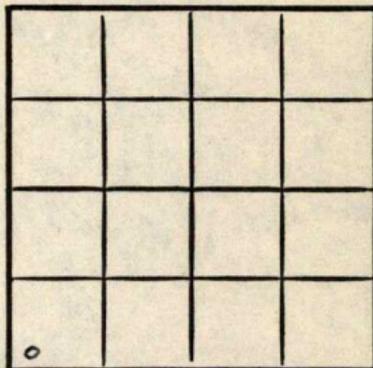

Barber County

Location X

Rig up \_\_\_\_\_

Drilling and Remarks:

RECORD

Cased \_\_\_\_\_ in., \_\_\_\_\_ ft.

Sand \_\_\_\_\_

Gas \_\_\_\_\_

Oil \_\_\_\_\_

Total Depth \_\_\_\_\_

PRODUCTION

1st 24 hrs. Nat. \_\_\_\_\_

1st 24 hrs. after shot \_\_\_\_\_

Gas \_\_\_\_\_ Cu. Ft.

Dry Hole \_\_\_\_\_

Abandoned \_\_\_\_\_

Date

FEB 4 1948

19

S. J. LEWIS

Scout

Map No. 61 Sec. 9 Twp. 33 R. 12W

Well No. 1 Boggs Est.

Magnolia Company

**COMPLETE** Contractor

SW/C

E. 1564

SECTION PLAT

0			

\_\_\_\_\_ Ft. from N. Line

330 Ft. from S. Line

\_\_\_\_\_ Ft. from E. Line

330 Ft. from W. Line

Barber County

Location \_\_\_\_\_

Rig up \_\_\_\_\_

Drilling and Remarks:

*Sump .4963*  
*5" @ 4963*  
*Flow 55 oil PT*  
*1, 970, 000 Gas*  
*393*

RECORD

Cased \_\_\_\_\_ in., \_\_\_\_\_ ft.

Sand \_\_\_\_\_

Gas \_\_\_\_\_

Oil

Total Depth 4883

PRODUCTION

1st 24 hrs. Nat. \_\_\_\_\_

1st 24 hrs. after shot \_\_\_\_\_

Gas \_\_\_\_\_ Cu. Ft.

Dry Hole \_\_\_\_\_

Abandoned \_\_\_\_\_

Date

APR 28 1948 19 \_\_\_\_\_ S. J. LEWIS Scout