


SECTION 9 TOWNSHIP 33 RANGE 12 W

WELL NO. #1 Jarnigan

COMPANY Monsanto (Lion)

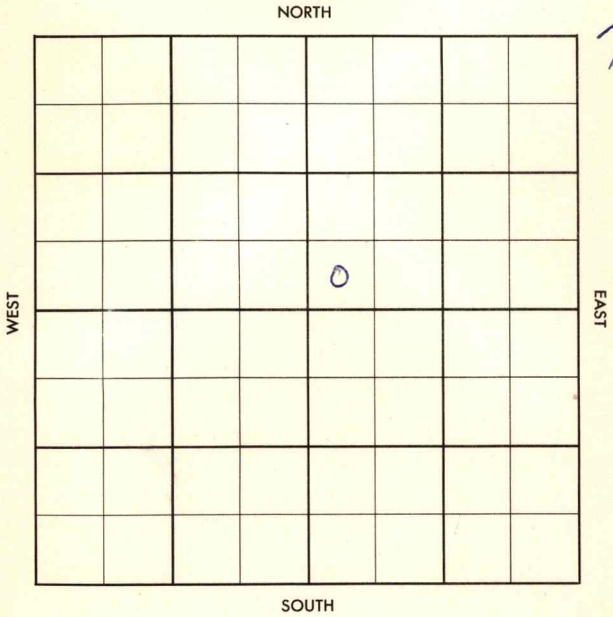

Barber

KANSAS

SEC. 9	TWP. 33	R. 12W
-----------	------------	-----------

WELL NO. #1 Jarnigan FARM

COMPANY Monsanto (Lion)

CONTRACTOR G-M-R


WILDCAT

_____ Ft. from N. Line

_____ Ft. from S. Line

_____ Ft. from E. Line

_____ Ft. from W. Line

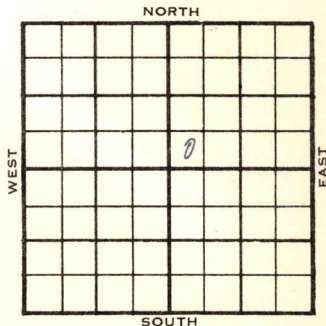

SW SW NE

Skelly - DHM

1956	ELEVATION 1533	REPORT
------	-------------------	--------

1-5 Comm. 12-31-55
8" @ 350/250
Drlg. 2555

1-25 DST 4442-60 op 1 hr. # 300' GIP, rec
30' mud, 245/20"
DST 4460-70 op 1/2 hr. rec. 15' mud, #/##
0/20"
DST 4878-96 op 1 hr. rec. 60' so&gcm,
0/20"
D & A
Elgin 3556
Heeb 3682 3690
Dg. sd. 3766- 3770
L. 3850- 3851
M. 4455 4455
K. 4658
V. 4766
S. 4862 4864
A. 4985 4984
TD 5018'

ABANDONED

County Barber Elev. _____
 Sec. 9 Twp. 33 Rge. 12W
 Company Monsanto (Lion)
 Farm Name Jarnigan No. 1

TOPS	DEPTH	LOG	DATUM
Anh.			
TP.			
H.			
Tr.			
Dg.			
BL.			
L.			
K.C.			
B.K.C.			
Ce.			
C.			
M.			
M.			
K.			
Mz.			
Mq.			
V.			
S.			
S.			
A.			
R.			
PE.			
G.			
T.D.			

Loc. in Sec. SW SW NE
 Geol. _____
 Contr. G-M-R
 Pool Wildcat
 FIRST REPORT
 JAN 5 '56

Date Comm. 12-31-55 Skelly DHM
8" @ 350/250 drlg. 2555

[Red scribbles]

Co.
Lse.
No.
Sec.
T.
R.

County Barber Elev. 1533
 Sec. 9 Twp. 33 Rge. 12W
 Company Monsanto
 Farm Name Jarnigan No. 1

TOPS	DEPTH	LOG	DATUM
Anh.			
T.P.			
H. <u>E/915</u>	<u>3556</u>		<u>2023</u>
Tr. <u>Neep</u>	<u>3682</u>	<u>3690</u>	<u>2157</u>
Dg. <u>sd</u>	<u>3766</u>	<u>3770</u>	<u>2237</u>
BL.			
L.	<u>3850</u>	<u>3851</u>	<u>2318</u>
K.C.			
B.K.C.			
Ce.			
C.			
M.	<u>4455</u>	<u>4455</u>	<u>2922</u>
M.			
K.		<u>4658</u>	<u>3125</u>
Mz.			
Mq.			
V.		<u>4766</u>	<u>3233</u>
S.	<u>4862</u>	<u>4864</u>	<u>3331</u>
S.			
A	<u>4985</u>	<u>4984</u>	<u>3451</u>
R.			
PE.			
G.			
TR.	<u>5015</u>	<u>5018</u>	

Loc. in Sec. SW SW NE

Geol. _____
 Contr. _____
G-M-R

Pool Wildcat



Date Comm. 12-31-55 JAN 25 1956

8" @ 350/250 DST 4442-60 open 1 hr.

300' GIP rec. 30' mud 245/20"

DST 4460-70 open 1/2 hr. rec. 15' mud

0/20" DST 4878-96 open 1 hr.

rec. 60' so & gcm 0/20"

D & A