


Map No. Stevens KANSAS Sec. 12 Twp. 33 R. 38th

Well No. 1-Argus Farm Argus Gas Company

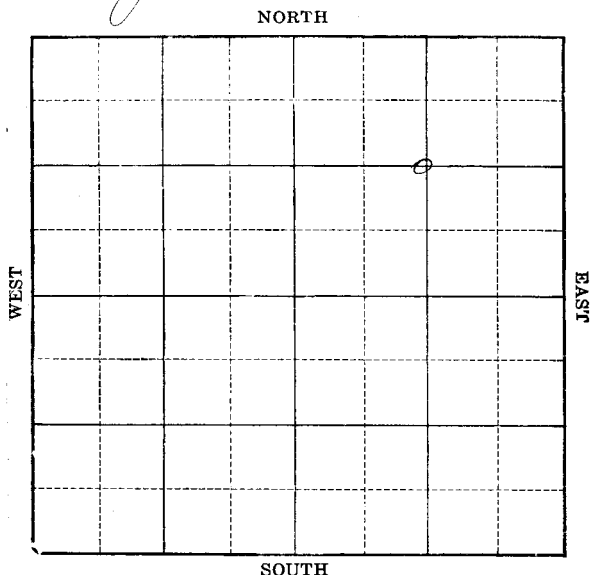

Location _____

Drilling Remarks _____

Rig Up _____

Drilling Remarks _____

RECORD

Cased _____ in. _____ ft.

Sand _____

Gas _____

Oil _____

Total Depth _____

PRODUCTION

1st 24 hrs. Nat. _____

1st 24 hrs. after shot _____

Gas _____ cu. ft.

Dry Hole _____

Abandoned _____


Map No. KANSAS Sec. 12 Twp. 33 R. 38^w
 Well No. 1- Ellis Farm
Argus Gas Company

1320 Ft. from N. Line

_____ Ft. from S. Line

1320 Ft. from E. Line

1930 Ft. from W. Line

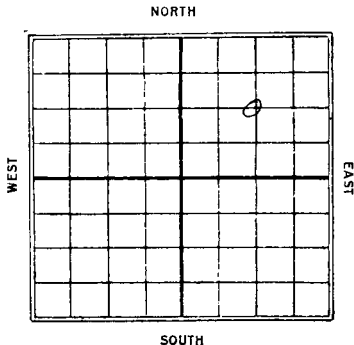


Date

REPORT

7/30	Loc
8/6	—
8/13	12" - 575'
8/20	Drly 2180'
8/27	8" - 2507'
9/3	Rust 2507'
9/10	Drly 2620'
9/17	" 2745'
7/24	" 2745'
10/1	No report
10/8	Sand 2530-2795
	TD 2795
	4 1/2 M gas
	Comp.


SECTION PLAT

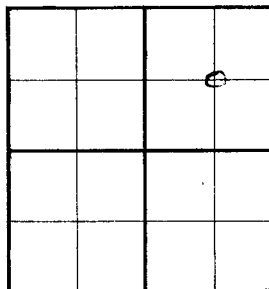1320 Ft. from N. Line Ft. from S. Line1320 Ft. from E. Line Ft. from W. Line

FIELD REPORTS

Location ✓Rig up

Drilling and Remarks:

RECORD

Cased in., ftSand Gas Oil Total Depth

PRODUCTION

1st 24 hrs. Nat. 1st 24 hrs. after shot Gas Cu. FtDry Hole Abandoned

Date

JUL 30 1930

19

S. J. LEWIS Scout

Map No. KANSAS Sec. 12 Twp. 33 R. 25 N

Well No. 1 Ellis

Crown Gas Company

Contractor


SECTION PLAT

1320 Ft. from N. Line

..... Ft. from S. Line

1320 Ft. from E. Line

..... Ft. from W. Line

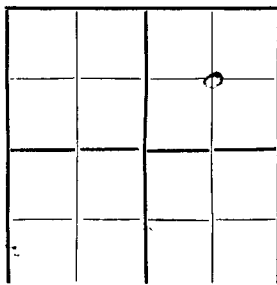

COMPLETED

Location

Rig up

Drilling and Remarks:

RECORD

Cased in., ft.

Sand 2530 - 2790

Gas 1 1/2

Oil

Total Depth 2795

PRODUCTION

1st 24 hrs. Nat.

1st 24 hrs. after shot

Gas Cu. Ft.

Dry Hole

Abandoned

Date

1930

192

S. J. LEWIS Scout