


2-33-13W

WELL LOG BUREAU—KANSAS GEOLOGICAL SOCIETY
508 East Murdock, Wichita, Kansas

Company- WILLIAM GRAHAM OIL COMPANY
Farm- Emma Magnison No. 1

SEC. 2 T. 33 R. 13W
C SW NW

Total Depth. 3833
Comm. 7-28-54 Comp. 8-7-54
Sector Treated.
Contractor. Graham-Messman-Rinehart Drlg Co.
Tested. 10-23-54

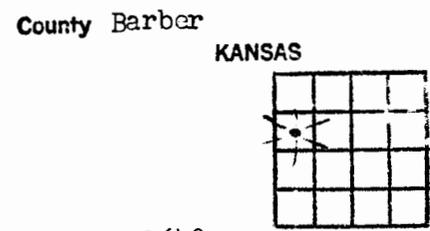

CASING:
8 5/8" 423' cem w/250 sx
5 1/2" 3815' cem w/ 50 sx

Elevation. 1648 K.B.
Production. 4,000,000 gas

Figures Indicate Bottom of Formations.

red bed	160
red bed, shells	1060
shale, shells	1720
shale, lime	2765
shale	2980
lime, shale	3115
shale, shells	3190
lime	3210
lime, shale	3355
lime	3432
lime, shale	3597
sand, shale, lime	3680
lime, shale	3770
shale	3817
Douglas	3827
sand, shale	3833 RTD
Total Depth	
Tops: Scout	
Douglas	3807