


Barbur
 Map No. **KANSAS** Sec. 24 Twp. 33 R. 13^w
 Well No. 1- Hamblin Farm
Barbara Oil Company

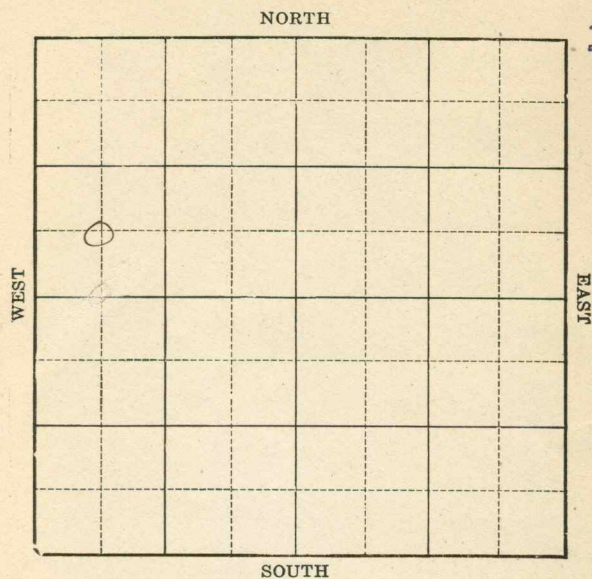

Location
 Drilling Remarks

Rig Up
 Drilling Remarks

RECORD


Cased . in. ft.
 Sand
 Gas
 Oil
 Total Depth

PRODUCTION

1st 24 hrs. Nat.
 1st 24 hrs. after shot
 Gas cu. ft.
 Dry Hole
 Abandoned

Map No. **KANSAS** Sec. 24 Twp. 33 R. 13^w
 Well No. 1- Hamblin Farm
Barbara Oil Company

_____ Ft. from N. Line
660 Ft. from S. Line
 _____ Ft. from E. Line
660 Ft. from W. Line
1930

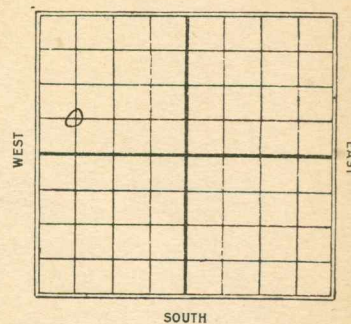

Date

REPORT

5/7 Co. G.
 5/14 Rig & tools
 5/21 lhlq. 1170'
 5/28 " 2300'
 6/4 " 3100'
 6/11 " 3370'
 6/18 " 3815'
 6/25 " 4260'
 7/2 rust 4260'
 7/9 8" 4400 rust.
 7/16 —
 7/23 show gas 4487'
307A gas 4508'
Isq. two string
tools
 7/30 —
 8/6 T. D. 4508'
Tools out -
Now Isq. bailer
 8/13 T. D. 4508'
 8/20 sledge pipe
8/27

9/3 - T.D. 4508' sledge
pipe

9/10 - T.D. 4508'

Rem 5" - 4450'

9/17 - Cly out

9/24 - T.D. 4528

mkg 12 1/2 ft gas

10/1 - Sand 4487-4528

T.D. 4528

19 ft gas

Comp.

Map No. **KANSAS** Sec. 24 Twp. 33 R. 19WWell No. 1 HamiltonBarbara Oil Company

Contractor

SECTION PLAT

Ft. from N. Line

660 Ft. from S. Line

Ft. from E. Line

660 Ft. from W. Line

COMPLETED

Location

Rig up

Drilling and Remarks:

RECORD

Cased in., ft.

Sand 4487-4528Gas 19.44

Oil

Total Depth 4528

PRODUCTION

1st 24 hrs. Nat.

1st 24 hrs. after shot

Gas Cu. Ft.

Dry Hole

Abandoned

Date

OCT 1 1930

192

S. J. LEWIS

Scout

Map No. **KANSAS** Sec. 24 Twp. 33 R. 19WWell No. 1 HamiltonBarbara Oil Company

Contractor

SECTION PLAT

Ft. from N. Line

660 Ft. from S. Line

Ft. from E. Line

660 Ft. from W. Line

FIRST REPORTS

Location

Rig up

Drilling and Remarks:

ROGS

RECORD

Cased in., ft.

Sand

Gas

Oil

Total Depth

PRODUCTION

1st 24 hrs. Nat.

1st 24 hrs. after shot

Gas Cu. Ft.

Dry Hole

Abandoned

Date

MAY 7 1930

192

S. J. LEWIS

Scout