



Section 27 Township 33 Range 13-W
Well Number #1 ~~1-27~~ B. E. Holmes "D"
Company Barbara Oil

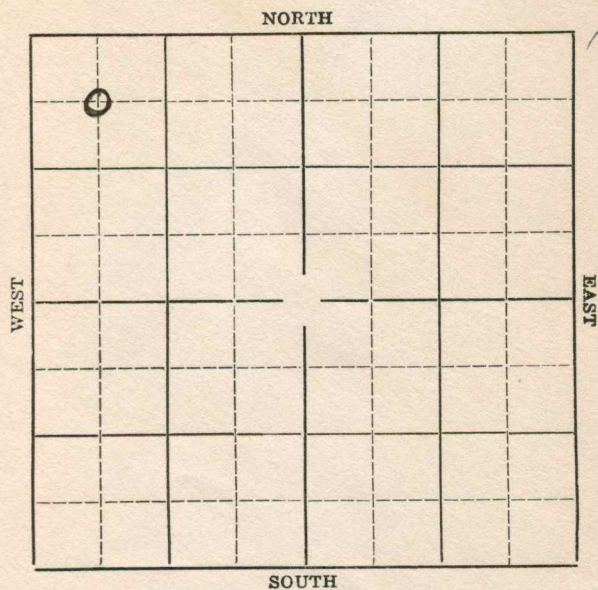

Sec. 27 Twp. 33 R. 13-W
Well No. #1-27 B. E. Holmes "D" Farm
Barbara Oil Company

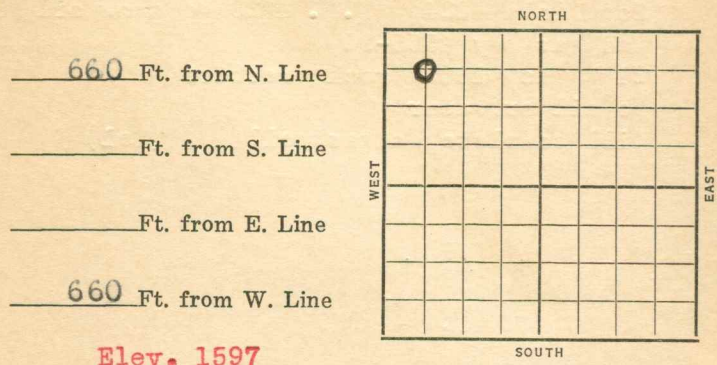

Date	REPORT
1937	
4/21	Location
4/30	"
5/7	Rot. rig.
5/14	" "
5/21	" "
5/28	20" @ 45'. 12" @ 254'.
	Drlg. 776'.
6/4	Drlg. 2540'.
6/11	Drlg. 3520'.
6/19	Drlg. 4210'.
6/25	K.C. 3980'. Chat 4488'.
	T.D. 4523'. Reaming hole.
7/2	Drlg. 4718'.
7/9	Chat 4480' (Corrected)
	7" @ 4482'. Viola 4824 $\frac{1}{2}$ '.
	T.D. 4828'.
	OVER OVER

7/15--Top Chat 4480 Set 7" 4482
Top Viola 4824 $\frac{1}{2}$ T.D. 4828 No show oil
Had gas pay 4555-90
21 M Gas 1600# rock pressure
No oil or water
Will complete as gas well (Tel)

7/21 7" @ 4482'
Viola 4826' (corrected)
TD 4829'
Pot. 21 M cu. ft. gas
No oil or water
Chat 4480'
gas pay 4555-90'

COMPLETED

Barber KANSAS

Map No. 93 Sec. 27 Twp. 33 R. 13^W

Well No. 1-B.E. Holmes "D"

Barbara Oil Company

Contractor

CORRECTION

660 Ft. from N. Line

Ft. from S. Line

Ft. from E. Line

660 Ft. from W. Line

SECTION PLAT

0			

Location

RECORD

Cased in., ft.

Rig up

Sand

Drilling and Remarks:

Gas

Oil

Total Depth

PRODUCTION

1st 24 hrs. Nat.

1st 24 hrs. after shot

Gas Cu. Ft.

Dry Hole

Abandoned

Date

JUL 7 1937 19

H. D. Hatfield Scout

Barber

Map No. 93 Sec. 27 Twp. 33 R. 13^W

Well No. 1-Holmes "D"

Barbara Oil Company

Contractor

COMPLETED

SECTION PLAT

660 Ft. from N. Line

Ft. from S. Line

Ft. from E. Line

660 Ft. from W. Line

0			

Location

RECORD

Cased 7 in., 4482 ft.

Rig up

Sand Viola 4826

Drilling and Remarks:

Gas (corrected)

Chat 4480

Oil

gas pay 4555-90

Total Depth 4829

PRODUCTION

Pot - 21 M. Cu. Ft. 943

1st 24 hrs. Nat.

1st 24 hrs. after shot

Gas Cu. Ft.

No oil or water

Dry Hole

Abandoned

Date

JUL 21 1937 19

H. D. Hatfield Scout

KANSAS

Barber

Map No. 93 Sec. 27 Twp. 33 R. 13W.Well No. 1-27 B. E. Holmes.Barbara Oil Company

Contractor

Special

SECTION PLAT

660 Ft. from N. Line

Ft. from S. Line

Ft. from E. Line

660 Ft. from W. Line

FIRST REPORT

0			

Location ✓

Rig up

Drilling and Remarks:

RECORD

Cased _____ in., _____ ft.

Sand _____

Gas _____

Oil _____

Total Depth _____

PRODUCTION

1st 24 hrs. Nat. _____

1st 24 hrs. after shot _____

Gas _____ Cu. Ft.

Dry Hole _____

Abandoned _____

Date

APR 21 1937

19

S. J. LEWIS

Scout