

KANSAS


FORM 51 5M 6-46 PETROL

Barber County

Section 29 Township 33 Range 13W

Well No. #1 Lasswell-McKaig

Company Barbara Oil

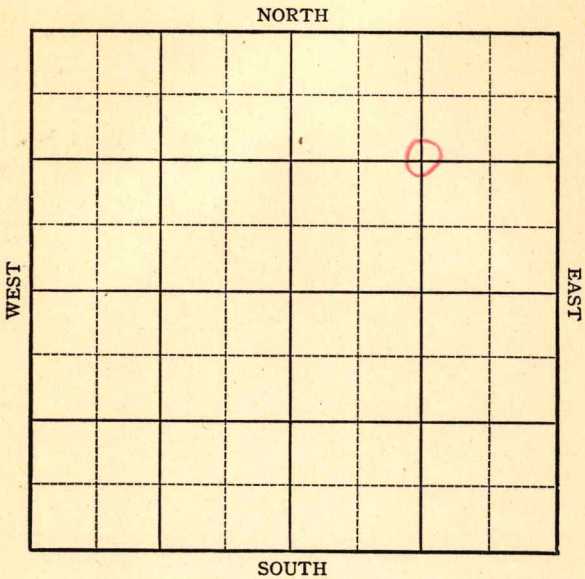

KANSAS

Sec. 29 Twp. 33 R. 13W

Well No. #1 Lasswell-McKaig Farm

Barbara Oil

Company

Medicine Lodge


1320 Ft. from N. Line

Ft. from S. Line

1320 Ft. from E. Line

Ft. from W. Line

C NE

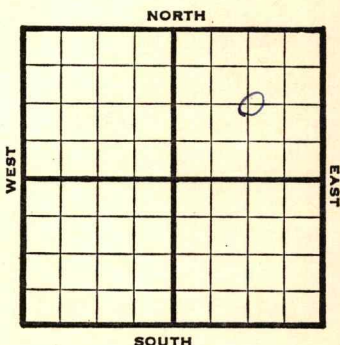

1946

1673

REPORT

7/10 Location

7/16 RUR

7/23 "

7/30 10" @ 311

Drlg 2465'

8/6 Drlg 3796'

8/13 Lans 4073

Miss 4615

Drlg 4690'

8/21 Viola 4925

TD 4950'

ABANDONED


KANSASKansas Pool Name Medicine LodgeMap No. 83 Sec. 29 Twp. 33 R. 13WWell No. 1 Lasswell-McKaigBarbara Oil

Company

FIRST REPORT

Contractor

C/NE

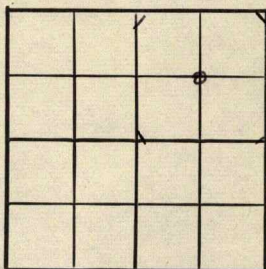SECTION PLAT1320 Ft. from N. Line Ft. from S. Line1320 Ft. from E. Line Ft. from W. LineBarber CountyLocation XRig up

Drilling and Remarks:

RECORDCased in., ft.Sand Gas Oil Total Depth **PRODUCTION**1st 24 hrs. Nat. 1st 24 hrs. after shot Gas Cu. Ft.Dry Hole Abandoned

Date

JUL 10 194619S. J. LEWIS

Scout

KANSAS

Kansas Pool Name Medicine LodgeMap No. 93 Sec. 29 Twp. 33 R. 13WWell No. 1 Lasswell-McKaigBarbara Oil Company


ABANDONED

Contractor

C NE

E 1/1673

SECTION PLAT

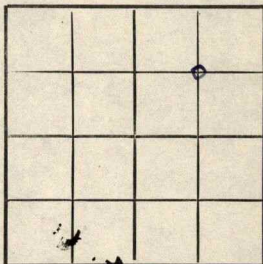1320 Ft. from N. Line Ft. from S. Line1320 Ft. from E. Line Ft. from W. Line

Barber County

Location Rig up

Drilling and Remarks:

Vista 4925

RECORD

Cased in., ft.Sand Gas Oil Total Depth 4950

PRODUCTION

1st 24 hrs. Nat. 1st 24 hrs. after shot Gas Cu. Ft.Dry Hole Abandoned

Date

AUG 21 1946 19S. J. LEWIS Scout