


Section 36 Township 33S Range 13W

Well No. #1 Holmes

Company Superior Oil Co.

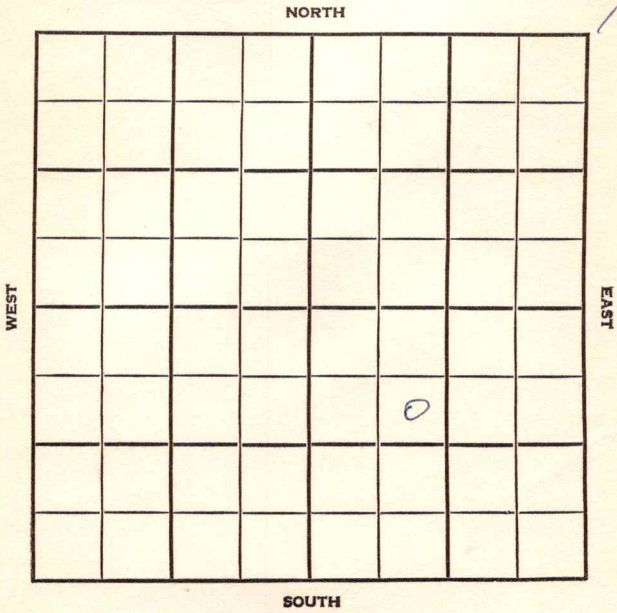

Barber


SEC. 36 TWP. 33S R. 13W

WELL NO. 1 Holmes COMPANY FARM

Superior Oil Company CONTRACTOR

Driftwood

_____ FT. FROM N. LINE
_____ FT. FROM S. LINE
_____ FT. FROM E. LINE
_____ FT. FROM W. LINE

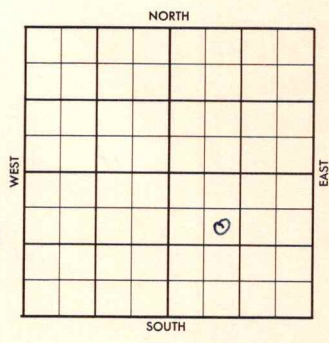

SE NW SE

1956 ELEVATION 1513' REPORT

6-20 Location (Miss. test)

8-15 Comm. 6-27-56
10 3/4" @ 312 w/225
7" @ 4616 w/300
CO 4608; 132/4568-90
2" tbg.
ga 5 mill. CFG; CP 730#;
Frac 10 x 10
ga 7,120 MCF; 3/4" chk.; TP 660#;
CP 1375#/
Cal. op flow; ga. 32,909 MCFGPD;
SIP 1370#.
Log tops: H. 3724'; L. 3914'; M. 4542';
TD 4618'

COMPLETED

County Barber Elev. _____
 Sec. 36 Twp. 33S Rge. 13W
 Company Superior Oil Co.
 Farm Name Holmes No. 1

TOPS	DEPTH	LOG	DATUM
------	-------	-----	-------

Loc. in Sec. _____

Anh.			
Tp.			
H.			
Tr.			
Dg.			
Bl.			
L.			
K.C.			
B.K.C.			
Ce.			
C.			
M.			
M.			
K.			
Mz.			
Mq.			
V.			
S.			
S.			
A.			
R.			
Pe.			
G.			
T.D.			

SE NW SE

Geol. _____

Contr. _____

Pool _____

Driftwood

FIRST REPORT			

Date Comm. JUN 20 '56

Loc. (Miss. test)

[Handwritten signature]

JUN 2 1956

[Handwritten signature]

Co.
Lse.
No.
Sec.
T.
R.

County Barber Elev. 1513
 Sec. 36 Twp. 33S Rge. 13W
 Company Superior Oil Co.
 Farm Name Holmes No. 1

TOPS	DEPTH	LOG	DATUM	Loc. in Sec.
Anh.				SE NW SE
Tp.				
H.		3724		
Tr.				
Dg.				
Bl.				
L.		3914		Geol.
K.C.				Contr.
B.K.C.				
Ce.				
C.				
M.		4542		Pool
M.				
K.				Driftwood
Mz.				
Me.				
V.				
S.				
S.				
A.				
R.				
PE.				
G.				
TD.	4618			

COMPLETE

Date Comm. AUG 15 '56

Loc. (Miss. test) JUN 27 '56 RUR JUL 3 '56

6-27-56 10³/₄ 312/225

10 2225 JUL 11 '56 10 4275 JUL 18 '56

7" @ 4616 / 300 CO 4608

132/4568-90 2" Tbg. JUL 25 '56

9a 5 MUI CFG CP 730#

11/2 Frac 10 x 10 9a 7,120

MCF 3/4" ch TY 660 CP 1375#

AUG 1 '56 AUG 13 '56 AUG 15 '56 571 Cal. op Flow

32,909 MCFGPD 51P 1370