


Section 30 Township 33 Range 13-W

Well No. #2 Larwell

Company Barbara Oil

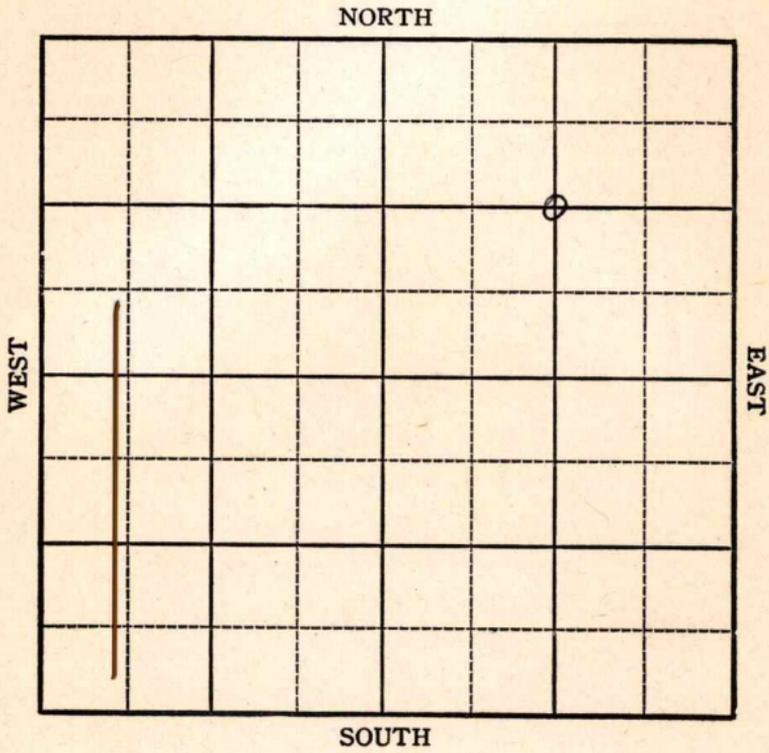

1

Sec. 30 Twp. 33 R. 13-W

Well No. #2 Laswell Farm

Barbara Oil Company


1320 Ft. from N. Line

_____ Ft. from S. Line

1320 Ft. from E. Line

_____ Ft. from W. Line

Elev. 1844

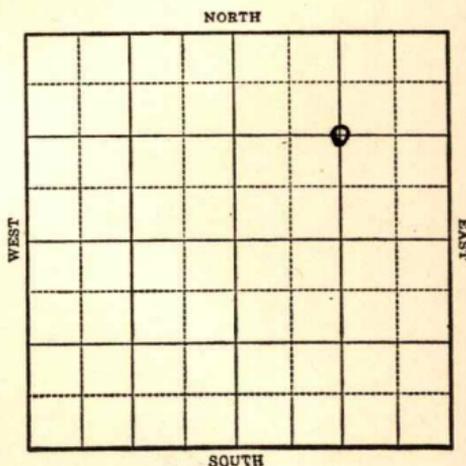

1943

R E P O R T

9/8	Location
9/15	"
9/22	"
9/29	Rotary
10/6	10" @ 296' Drlg. 2040'
10/13	4" rlg. 3000'
10/20	Drlg. 1810'
10/27	Drlg. 4360'
11/3	Lans 4202 Miss 4820 Drlg. 5040'
11/10	Viola 5056 T.D. 5072' 7" @ 5072 to perf.
11/17	Lans 4202 Miss 4820 Viola 5056 7" @ 5072 84 shots 4815-62 T.D. 5072 12 M Gas.

COMPLETED

KANSAS

Map No. 93 Sec. 30 Twp. 33 R. 13W

Well No. 2 Laswell

Barbara Oil Company

FIRST REPORT Contractor

C NE

SECTION PLAT


1320 Ft. from N. Line

_____ Ft. from S. Line

1320 Ft. from E. Line

_____ Ft. from W. Line

Medicine Lodge
Pool

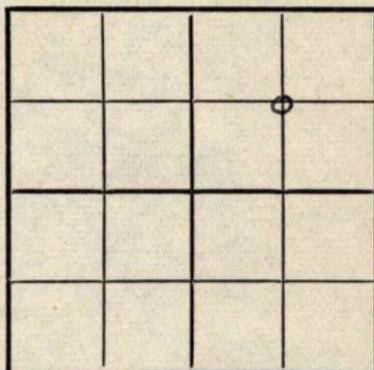

Location X

Rig up _____

Drilling and Remarks:

RECORD

Cased _____ in., _____ ft.

Sand _____

Gas _____

Oil _____

Total Depth _____

PRODUCTION

1st 24 hrs. Nat. _____

1st 24 hrs. after shot _____

Gas _____ Cu. Ft.

Dry Hole _____

Abandoned _____

Date

SEP 8 1943 19 _____

S. J. LEWIS Scout

KANSAS

Map No. 93 Sec. 30 Twp. 33 R. 13W

Well No. 2 Laswell

Barbara Oil Company

COMPLETED Contractor

C NE


SECTION PLAT

1320 Ft. from N. Line

_____ Ft. from S. Line

1320 Ft. from E. Line

_____ Ft. from W. Line

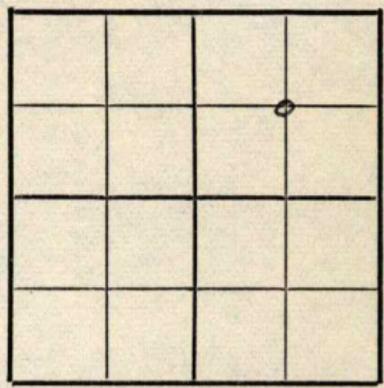

Medicine Lodge Pool

Location _____

Rig up _____

Drilling and Remarks:

Loss 4202
Miss 4820
Viola 5056
7" @ 5072
84 shots 4815-62

12 M Gas

RECORD

Cased _____ in., _____ ft.
Sand _____
Gas _____
Oil _____
Total Depth 5072

PRODUCTION

1st 24 hrs. Nat. _____
1st 24 hrs. after shot _____
Gas _____ Cu. Ft.
Dry Hole _____
Abandoned _____

Date

NOV 17 1943 19

S. J. LEWIS Scout