

Barber

**KANSAS**

SECTION 36 TOWNSHIP 33 RANGE 13 W

WELL NO. #1 Hall "F"

COMPANY Petroleum Inc.

NORTH

9

WEST

EAST

						0	

SOUTH

Barber

KANSAS

SEC. 36	TWP. 33	R. 13W
------------	------------	-----------

WELL NO. #1 Hall "F" FARM

COMPANY Petroleum Inc.

CONTRACTOR Garvey


WILDCAT

\_\_\_\_\_ Ft. from N. Line

\_\_\_\_\_ Ft. from S. Line

\_\_\_\_\_ Ft. from E. Line

\_\_\_\_\_ Ft. from W. Line

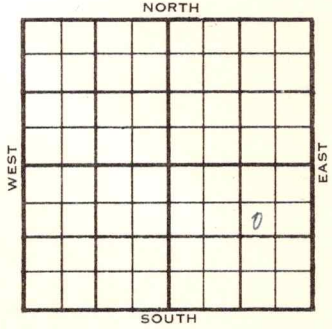

SW NE SE

	ELEVATION	REPORT
--	-----------	--------

1956

1-18

MIR

County Barber Elev. \_\_\_\_\_  
 Sec. 36 Twp. 33 Rge. 13W  
 Company Petroleum Inc.  
 Farm Name Hall "F" No. 1

TOPS	DEPTH	LOG	DATUM
Anh.			
Tr.			
H.			
Tr.			
Dg.			
B.L.			
L.			
K.C.			
B.K.C.			
Ce.			
C.			
M.			
M.			
K.			
Mz.			
Me.			
V.			
S.			
S.			
A.			
R.			
Pe.			
G.			
T.D.			

Loc. in Sec. SW NE SE  
 Geol. \_\_\_\_\_  
 Contr. Garvey  
 Pool Wildcat

JAN 18 '56		
FIRST REPORT		

Date Comm. M I R

Co.  
Sec.  
T.  
R.