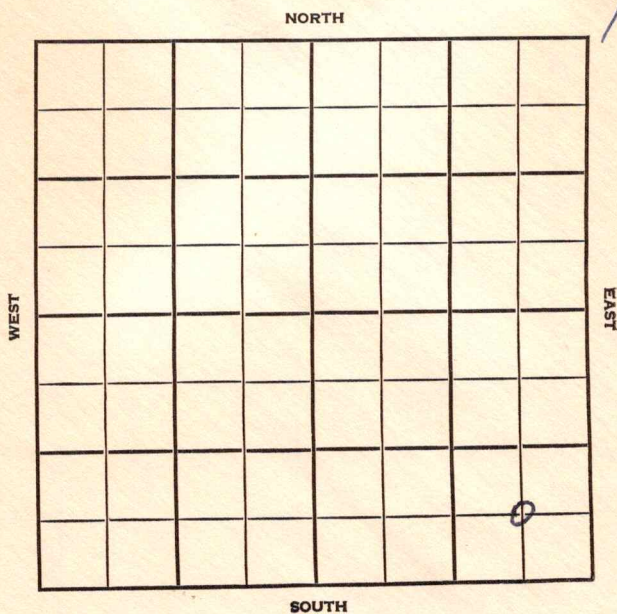


Section 33 Township 33 Range 13WWell No. 1 Holmes "A"Company G-M-R Oil

Barber

KANSAS

SEC.	TWP.	R.
33	33	13W

WELL NO.

COMPANY

CONTRACTOR

#1 Holmes "A"

FARM

G-M-R Oil

Co. Tools.

Medicine Lodge Pool

Ft. from N. Line

660


Ft. from S. Line

660

Ft. from E. Line

Ft. from W. Line

C SE SE

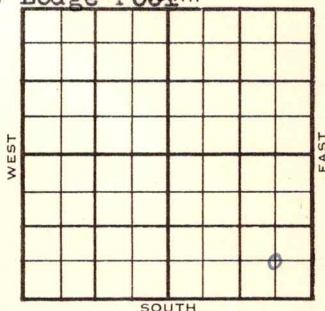

1955

ELEVATION

1719'

REPORT

2/16

M I R

3/16

Spud 2-17-55 D&A, TD 5215
 8" @ 330, Heeb 3983,
 DST 3983-4050, open 1 1/2 hr.
 gas in 62 min. 150' mud 1380#
 Lans 4161, Miss 4717,
 DST 4715-90 open 1 hr Rec 40'
 mud, 110#
 DST 4791-4844, open 1 hr Rec
 25' mud VSSO 0# KH 4941,
 Chattanooga 4999, Misener 5048,
 Viola 5050, Simp Sh 5163,
 Simp Sd 5189,
 DST 5191-5215, open 1 hr Rec
 25' mud 0# TD 5215
 D&A

ABANDONED

County Barber State KansasSec. 33 (Blk.) 33 (Sur.) 13W Map No.Operator G-M-R OilWell No. 1 Farm Holmes "A"Elev. Location C SE SE660 Ft. From S Line SE660 Ft. From E Line Quarter1st. Report FEB 16 1955

Completion

Remarks

Co. tools

Spudding Date

Drlg. Data Medicine Lodge PoolM I R

FABEN GILSTRAP

County Barber State Kan

Sec. 33 (Blk. 33 (Sur. 13W Map No.)
(Twp.) (Rge.)

Operator G-M-R Oil

Well No. 1 Farm Holmes "A"

Elev. 1719 Location C SE SE



660 Ft. From S Line SE

660 Ft. From E Line Quarter

1st. Report

Completion MAR 1 6 1955

Remarks Wildcat

Co. tools

Spudding Date 2-17-55

Drlg. Data D & A TD 5215

8" @ 330 Heeb. 3983 DST 3983-4050

open 1 $\frac{1}{2}$ hr. gas in 62 min. 150' mud

1380# Lans. 4161 Miss. 4717 DST 4715-

90 open 1 hr. Rec. 40' mud 110#

DST 4791-4844 open 1 hr. Rec. 25' mud

VSSO 0# Kh. 4941 Chattanooga 4999

Misener 5048 Viola 5050 Simp. sh. 5163

Simp. sd. 5189 DST 5191-5215 open 1 hr.

Rec. 25' mud 0# TD 5215

D & A

FABEN GILSTRAP