


Barber
 Map No. KANSAS Sec. 1 Twp. 33 R. 13^w
 Well No. F- Lanker Farm
Barbara Oil Company

_____ Ft. from N. Line
660 Ft. from S. Line
 _____ Ft. from E. Line
660 Ft. from W. Line

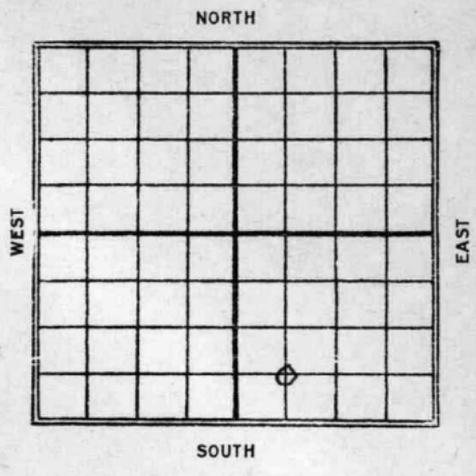

1929

Date	REPORT
10/23	Rog (rotary)
10/30	
11/6	Rig
11/13	Rig up
11/20	
11/27	90' SP
12/4	Relg 1605
12/11	" 2070
12/18	" 2800'
12/23	" 3125'
12/30	" 3620'
1930	
1/8	" 3815'
1/15	" 4100'
1/22	Trg drly pipe 4100'
1/29	
2/5	Log out
2/12	Relg 4195'
2/19	" 4405
2/26	" 4476
3/5	Cement casing 6"

3/2 - 4538 - Rust.

3/19 - Sg. out - 4538'

3/26 - " " 4720

4/2 - J.D. 4780

Dry & Abandon

Map No. **KANSAS** Sec. 1 Twp. 23 R. 12W

Well No. 1 Lanber

Barbara Oil Company

Contractor

SECTION PLAT

.....Ft. from N. Line

660 Ft. from S. Line

.....Ft. from E. Line

660 Ft. from W. Line

FIRST REPORTS

Location.....

Rig up.....

Drilling and Remarks:

ROG
Rotary

RECORD

Cased.....in.,ft.

Sand.....

Gas.....

Oil.....

Total Depth.....

PRODUCTION

1st 24 hrs. Nat.....

1st 24 hrs. after shot.....

Gas.....Cu. Ft.

Dry Hole.....

Abandoned.....

Date

OCT 23 1929

S. J. LEWIS

Scout

Map No. KANSAS Sec. 1 Twp. 33 R. 13W

Well No. 1 Tanker

Barbara Oil Company

Contractor

SECTION PLAT

..... Ft. from N. Line

660 Ft. from S. Line

..... Ft. from E. Line

660 Ft. from W. Line

		0	

ABANDONED

Location.....

Rig up.....

Drilling and Remarks:

RECORD

Cased..... in., ft.

Sand.....

Gas.....

Oil.....

Total Depth 4780

PRODUCTION

1st 24 hrs. Nat.....

1st 24 hrs. after shot.....

Gas..... Cu. Ft.

Dry Hole.....

Abandoned.....

Date

APR 2 - 1930

192

S. J. LEWIS

Scout