


Section 1 Township 33 Range 13W

Well No. #1 G.S. Lonker

Company Skelly Oil

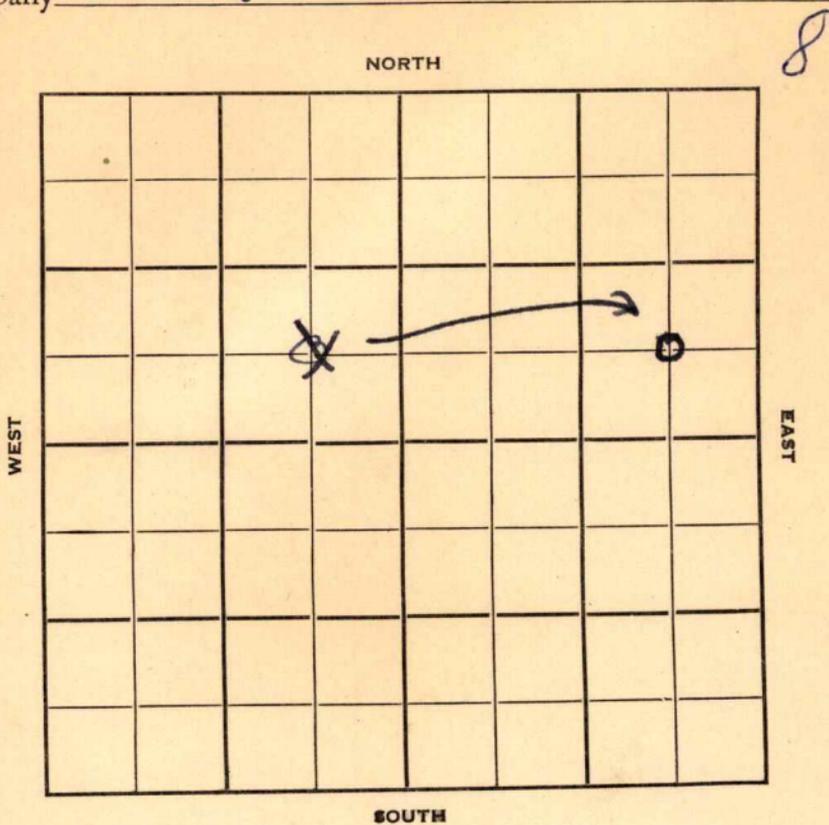

Sec. 1 Twp. 33 R. 13 W

Well No. # 1 G. S. Lonker Farm

Skelly Oil Company


Contractor

Ft. from N. Line

660 Ft. from S. Line

660 Ft. from E. Line

Ft. from W. Line

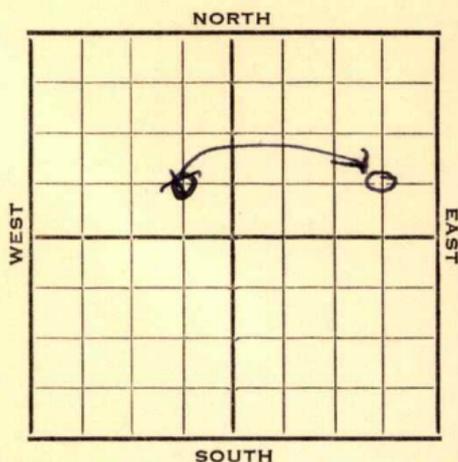

C SE NE
NW

1952 Elev. 1809' REPORT

11/5 Location
11/12 Drlg. 50'
11/20 Drlg. 2750'
11/27 **Elgin 3735**
DST 3730-3830, 1 hr., 300' SW
DST 3968-4003, RTD 20 mins.,
6 1/2 M gas 1230# 5" @
12/4 5" @ 3972'
12/11 NR
12/18 CO 4003 F 6 1/2 Gas
12/25 " " "
12/30 Spud 11-10-52
Gas well TD 4003' 8" @ 366
Elgin 3735'
DST 3730-3830 open 1 hr. rec 300' SW
1230#
DST 3968-4003, open 20 min, rec 6 1/2 MCFG
1230# 5" @ 3792 CO to 4003
Comp. 6 1/2 MCFGPD
COMPLETED

Kansas

Map No. _____ Sec. 1 Twp. 33 R. 13W

Well No. 1 J. S. Lonker

Skelly Oil Company

CORRECTION

Contractor

C SE NE

SECTION PLAT

			o

_____ Ft. from N. Line

660 Ft. from S. Line

660 Ft. from E. Line

_____ Ft. from W. Line

Barber County

Location _____

Rig up _____

Drilling and Remarks:

Reported

C SE NW

RECORD

Cased _____ in., _____ ft.

Sand _____

Gas _____

Oil _____

Total Depth _____

PRODUCTION

1st 24 hrs. Nat. _____

1st 24 hrs. after shot _____

Gas _____ Cu. Ft.

Dry Hole _____

Abandoned _____

Date

NOV 12 1962

19

J. G. MCGEHEE

Scout


County Barber State Kansas

Sec. 1 (Blk.) 33 (Sur. Rge.) 13W Map No.

Operator Skelly Oil

Well No. 1 Farm G. S. Lonker

Elev. 1809 Location C SE NE

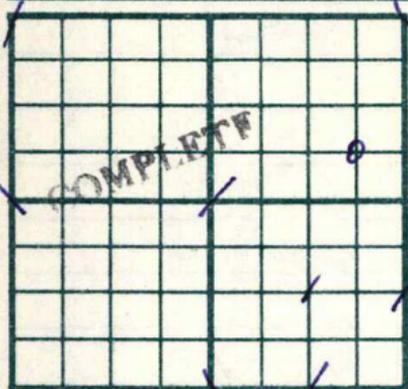

660 Ft. From S Line NE

660 Ft. From E Line Quarter

1st. Report

Completion DEC 30 1952

Remarks

Spudding Date 11-10-52

Drlg. Data Gas well TD 4003

8" @ 366 Elgin 3735 DST 3730-3830

open 1 hr. Rec. 300' sw 1230#

DST 3968-4003 open 20 min. Rec. 6 1/2 mcfg

1230# 5" @ 3792 CO to 4003

Comp. 6 1/2 mcfgpd


County **Barber** State **Kansas**

Sec. **1** (Blk. Twp.) **33** (Sur. Rge.) **13W** Map No.

Operator **Skelly Oil**

Well No. **1** Farm **G. S. Lonker**

Elev. Location **C SE NW**

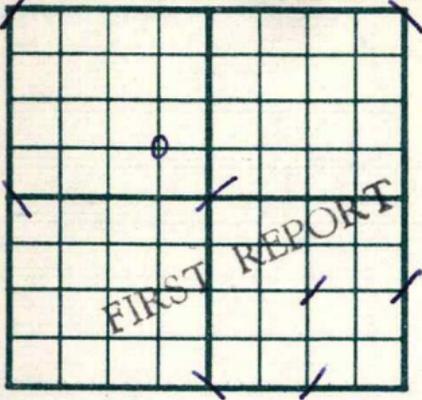

660 Ft. From **S** Line **NW**

660 Ft. From **E** Line Quarter

1st. Report **NOV 5 1952**

Completion

Remarks

Spudding Date

Drlg. Data

Location