


Section 2 Township 33 Range 13W

Well No. #1 Warwick

Company K & E Drlg.

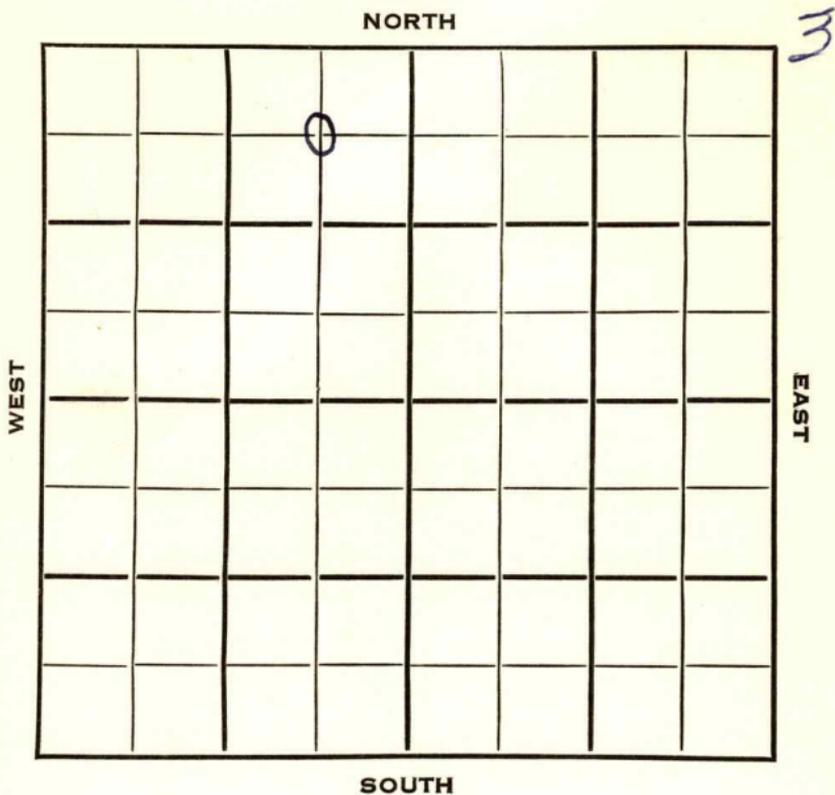

Barber

KANSAS ✓


SEC. 2	TWP. 33	R. 13W
-----------	------------	-----------

WELL NO. #1 Warwick FARM

COMPANY K & E Drlg.

CONTRACTOR K & E Drlg.  
Wildcat.

660 Ft. from N. Line  
Ft. from S. Line  
660 Ft. from E. Line  
Ft. from W. Line

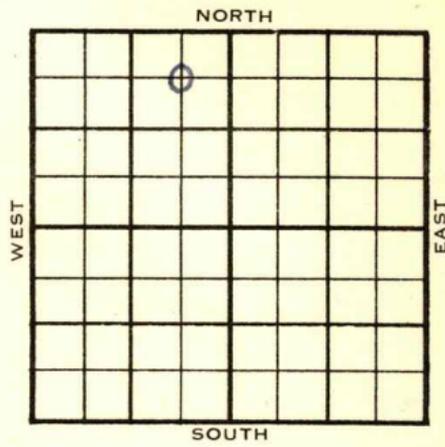

C NE NW

	ELEVATION	REPORT
1953	1631'	
9/30	Location	
10/14	8" @ 409'	Drlg 790'
10/21	Drlg 2839'	
10/28	Heeb 3704', Doug 3780'	DST 3781'-3809' 20 min, 5 1/4 M gas, TD 3809'
	Elec log.	
11/4	5" @ 3781'	
11/24	Spud 10-12-53	Gas Well
	TD 3818'	8" @ 409'
	Heeb 3704', Doug. 3780'	DST 3781-3809', opn 20 mins., rec. 5 1/4 mcfg
	TD 3809'	5" @ 3781'
	DD 3818'	5,690,000 gas
	Comp. 10,037,000 gas, 1055#	

COMPLETED

County **Barber** State **Kansas**

Sec. **2** (Blk. **33**) (Sur. **13W**) (Twp.) **Map No.**

Operator **K & E Drlg.**

Well No. **1** Farm **Warwick**

Elev. \_\_\_\_\_ Location **C NE NW**



**660** Ft. From **N** Line **NW**

**660** Ft. From **E** Line **Quarter**

1st. Report **SEP 30 1953**

Completion \_\_\_\_\_

Remarks \_\_\_\_\_

**K & E Drlg. - Contr.**

Spudding Date \_\_\_\_\_

Drlg. Data **Wildcat**

**Location**

