


Section 9 Township 33 Range 13-W

Well No. #1 J. H. Trice "A"

Company Barbara Oil

NORTH Medicine Lodge Pool

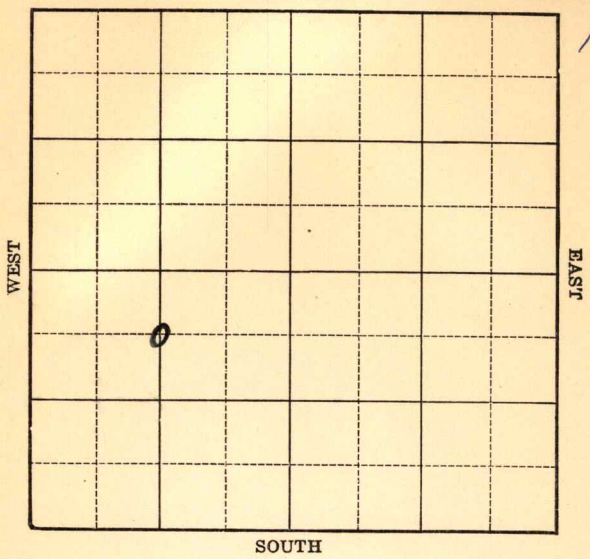



Map No. 73 Sec. 9 Twp. 33 R. 13W

Well No. 1 J. H. Trice "A"

Barbara Oil Company

Contractor

**FIRST REPORT**

C  $N\frac{1}{2}$  SW


660 Ft. from N. Line

\_\_\_\_\_ Ft. from S. Line

\_\_\_\_\_ Ft. from E. Line

1320 Ft. from W. Line

**SECTION PLAT**

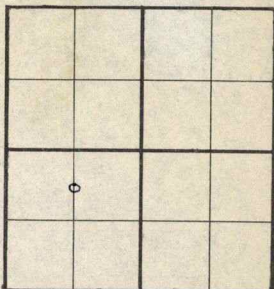

**MEDICINE LODGE POOL**

Location \_\_\_\_\_

Rig up \_\_\_\_\_

Drilling and Remarks:  
Cellar

**RECORD**

Cased \_\_\_\_\_ in., \_\_\_\_\_ ft.

Sand \_\_\_\_\_

Gas \_\_\_\_\_

Oil \_\_\_\_\_

Total Depth \_\_\_\_\_

**PRODUCTION**

1st 24 hrs. Nat. \_\_\_\_\_

1st 24 hrs. after shot \_\_\_\_\_

Gas \_\_\_\_\_ Cu. Ft.

Dry Hole \_\_\_\_\_

Abandoned \_\_\_\_\_

Date

MAY 29 1940 19

S. J. LEWIS

Scout

Map No. 93 Sec. 9 Twp. 33 R. 13W

Well No. 1 J. H. Trice "E"

Barbara Oil Company

Contractor

**COMPLETED**

**SECTION PLAT**

C N $\frac{1}{2}$  SW

660 Ft. from N. Line

\_\_\_\_\_ Ft. from S. Line

\_\_\_\_\_ Ft. from E. Line

1320 Ft. from W. Line

|  |  |  |  |
|--|--|--|--|
|  |  |  |  |
|  |  |  |  |
|  |  |  |  |
|  |  |  |  |
|  |  |  |  |

**MEDICINE LODGE POOL**

Location \_\_\_\_\_

Rig up \_\_\_\_\_

Drilling and Remarks:

*Miss 4620*

*7" @ 4640*

*23 M Gas*

**RECORD**

Cased \_\_\_\_\_ in., \_\_\_\_\_ ft.

Sand \_\_\_\_\_

Gas \_\_\_\_\_

Oil \_\_\_\_\_

Total Depth 4719

**PRODUCTION**

1st 24 hrs. Nat. \_\_\_\_\_

1st 24 hrs. after shot \_\_\_\_\_

Gas \_\_\_\_\_ Cu. Ft.

Dry Hole \_\_\_\_\_

Abandoned \_\_\_\_\_

Date

JUL 24 1940 19

S. J. LEWIS Scout