

Barber

Form 51-5M-9-28-27423

Map No. **KANSAS** Sec. 12 Twp. 33 R. 13^w

Well No. 1 - Lytle Farm
Barbara Oil Company

NORTH

| | | | | | | | |
|--|--|--|---|--|--|--|--|
| | | | | | | | |
| | | | | | | | |
| | | | | | | | |
| | | | | | | | |
| | | | o | | | | |
| | | | | | | | |
| | | | | | | | |
| | | | | | | | |

11

WEST

EAST

SOUTH

Location.....

Drilling Remarks.....

.....

.....

Rig Up.....

Drilling Remarks.....

.....

.....

RECORD

PRODUCTION

Cased..... in..... ft.

Sand.....

Gas.....

Oil.....

Total Depth.....

1st 24 hrs. Nat.....

1st 24 hrs. after shot.....


Gas..... cu. ft.....

Dry Hole.....

Abandoned.....

Map No. **KANSAS** Sec. 12 Twp. 33 R. 13^w
 Well No. 1 - Lytle Farm
Barbara Oil Company

100 Ft. from N. Line
 Ft. from S. Line
100 Ft. from E. Line
 Ft. from W. Line

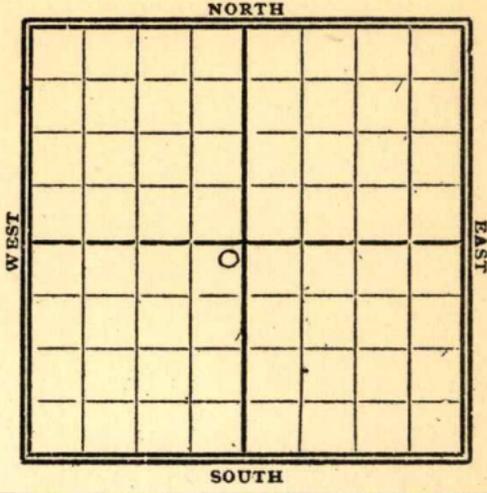

1928

| Date | REPORT |
|-------|--|
| 12/19 | Rig |
| 12/26 | |
| 1929 | |
| 1/2 | Spud |
| 1/9 | |
| 1/16 | drlg 2630' |
| 1/23 | " 3260' |
| 1/30 | " 3650' |
| 2/6 | " 4010' |
| 2/13 | " 4285' |
| 2/20 | " 4434' |
| 2/27 | Run 8" - 4478' |
| 3/6 | Drly cement 4478' |
| 3/13 | |
| 3/18 | Top sand 4559-TD4560 Ast 20 M gas fsg tools 4560'-TD |
| 3/20 | 25 M gas 4559-68' 1750# rock pressure drly 4568' |
| 3/27 | show black oil 4576' Drly 4614' |

4/3- Only 4646'

4/10- HFW 4646-51'

To P.B. to gas sand 4568

4/17- sand 4548-60'

TD. 4560'

22-A gas

Pump for gas

Barber

Map No. KANSAS Sec. 12 Twp. 33 R. 13W

No. MOP

Well No. Lytte

Barbara Oil

Company

Contractor

SECTION PLAT

100 Ft. from N. Line

..... Ft. from S. Line

100 Ft. from E. Line

10 Ft. from W. Line

| | | | |
|--|--|---|--|
| | | | |
| | | | |
| | | 0 | |
| | | | |
| | | | |

FIRST REPORTS

Location.....

Rig up.....

Drilling and Remarks:

Rig

RECORD

Cased..... in., ft.

Sand.....

Gas.....

Oil.....

Total Depth.....

PRODUCTION

1st 24 hrs. Nat.....

1st 24 hrs. after shot.....

Gas..... Cu. Ft.

Dry Hole.....

Abandoned.....

Date

DEC 19 1928

192.....

S. J. LEWIS

Scout

Map No. **KANSAS** Sec. 12 Twp. 23 R. 13W

Well No. 127te

Barbara Oil Company

Contractor

SECTION PLAT

100 Ft. from N. Line

..... Ft. from S. Line

100 Ft. from E. Line

..... Ft. from W. Line

| | | | |
|--|--|---|--|
| | | | |
| | | | |
| | | o | |
| | | | |

COMPLETED

Location.....

Rig up.....

Drilling and Remarks:

Sand 4548-60

22M Gas

RECORD

Cased..... in., ft.

Sand.....

Gas.....

Oil.....

Total Depth 4560

PRODUCTION

1st 24 hrs. Nat.....

1st 24 hrs. after shot.....

Gas..... Cu. Ft.

Dry Hole.....

Abandoned.....

Date

APR 17 1929

S. J. LEWIS

Scout