


DX 78-1

Section 2 Township 33 Range 13W

Well No. 1 Emma Magnison

Company Bill Graham, LeBosquet & W. Kuhn.

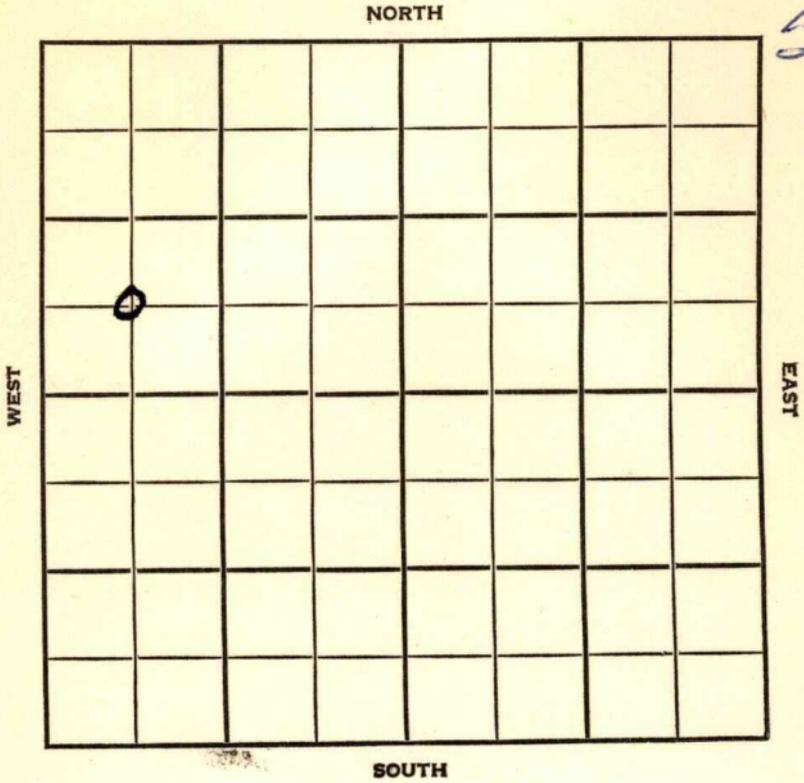

Barber

KANSAS

SEC.	TWP.	R.
2	33	13 W

WELL NO.

1 Emma Magnison

FARM

COMPANY

Bill Graham, LeBosquet & W. Kuhn

CONTRACTOR

G-M-R

Medicine Lodge Pool


NORTH

_____ Ft. from N. Line

660 _____ Ft. from S. Line

_____ Ft. from E. Line

660 _____ Ft. from W. Line

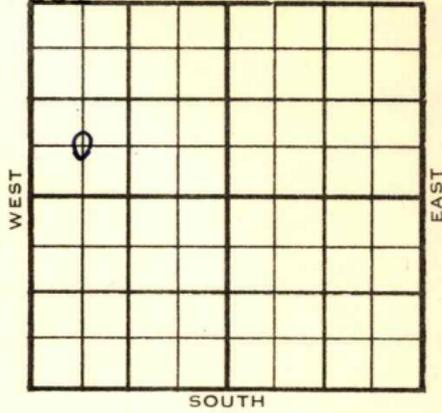

C SW NW

CSO Farmout

	ELEVATION	REPORT
1954	1645'	

8/4 Spud 7-28-54
8" @ 423
Drlg. 3085'

9/15 Spud 7-28-54
Gas Well
TD 3833'
8" @ 423'
DST 3580'-97' opn 1 hr, rec 230' muddy
wtr, 1450# Doug 3807'
DST 3787'-3817' opn 1½ hr, gas in 11
min, 350,000 cfg. 1 hr. 434,000 cfg.
1½ hr. 800#
TD 3833'
5" @ 3815'
CO to 3833'
Comp open flow 4,000,000 cfgpd 900#

COMPLETED

County **Barber** State **Kansas**
 Sec. **2** (Blk.) **33** (Sur.) **13W** Map No.
 (Twp.)
 Operator **Bill Graham, LeBosquet & W. Kuhn**
 Well No. **1** Farm **Emma Magnison**
 Elev. **1645** Location **C SW NW**



660 Ft. From **S** Line **NW**
660 Ft. From **W** Line **Quarter**
 1st. Report **AUG 4 1954**
 Completion
 Remarks **CSO farmout**
G-M-R - Contr.
 Spudding Date **7-28-54**

Drlg. Data **Medicine Lodge Pool**
8" @ 423 drlg. 3085

