

Barber


DX 78-1

KANSAS.

Section 3 Township 33 Range 13W

Well No. #1 H.V. Magnison

Company G-M-R Oil

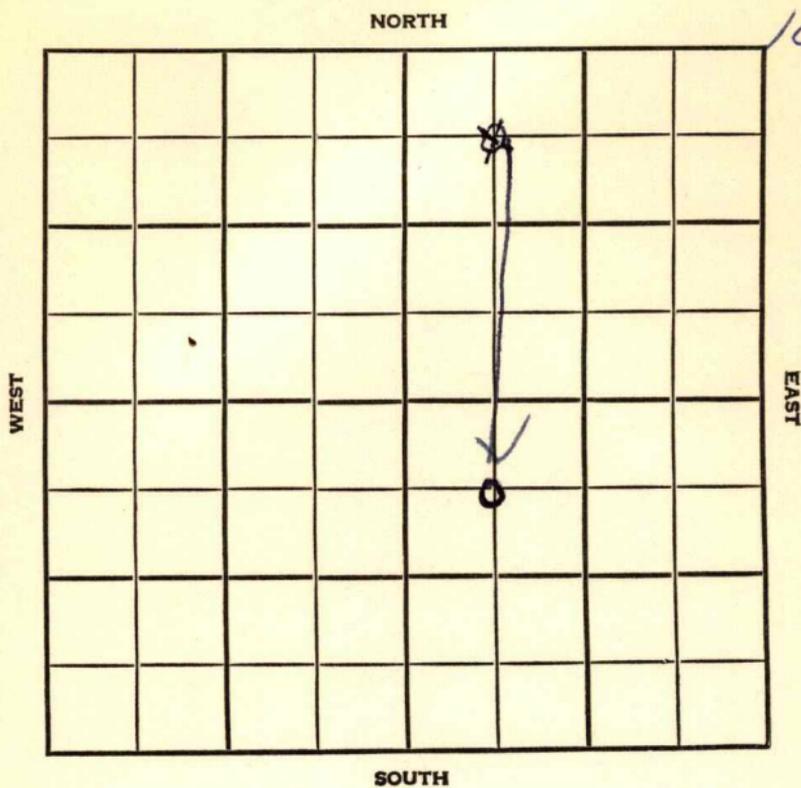

Barber KANSAS

SEC. 3 TWP. 33 R. 13W


WELL NO. 1 H. V. Magnison FARM

COMPANY G-M-R Oil

CONTRACTOR G-M-R

Medicine Lodge Pool

660 Ft. from N. Line
Ft. from S. Line
Ft. from E. Line
660 Ft. from W. Line

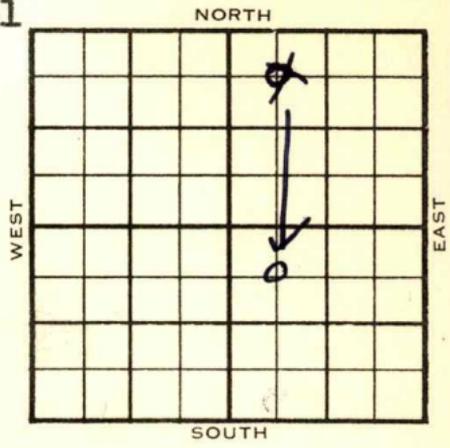

C NW ^{SE} NE
CSO FO

ELEVATION 1954 1687' REPORT

8/11 Spdg 8-7-54
8" @ 280
Drlg. 1915

8/25 Spud 8-7-54 D & A TD 3909
8" @ 280 Elgin sd 3651
DST 3820-75 open 1 hr rec 50' mud
550#
DST 3872-94 open 1 hr gas in 11 min
76,000 CFG, rec 330' GCSW 855#
Heeb 3810 Doug. 3821 Doug. sd 3838
DST 3892-3909 open 1 hr rec 480' SW
1140# TD 3909'
D & A

ABANDONED

Map No. _____ Sec. 3 Twp. 33 R. 13W

Well No. 1 H. V. Magnison

G-M-R Oil Company

CORRECTION Contractor

C NW SE

660 Ft. from N. Line

_____ Ft. from S. Line

_____ Ft. from E. Line

660 Ft. from W. Line

SECTION PLAT

		o	

Barber County

Location _____

Rig up _____

Drilling and Remarks:

Reported
C NW NE

RECORD

Cased _____ in., _____ ft.

Sand _____

Gas _____

Oil _____

Total Depth _____

PRODUCTION

1st 24 hrs. Nat. _____

1st 24 hrs. after shot _____

Gas _____ Cu. Ft.

Dry Hole _____

Abandoned _____

Date

FABEN GILSTRAP

AUG 18 1954

19

Scout

County **Barber** State **Kansas**

Sec. **3** (Blk. Twp.) **33** (Sur. Rge.) **13W** Map No.

Operator **G-M-R Oil**

Well No. **1** Farm **H. V. Magnison**

Elev. Location **C NW NE**



660 Ft. From **N** Line **NE**

660 Ft. From **W** Line Quarter

1st. Report **AUG 11 1954**

Completion

Remarks **CSO - FO**

G-M-R - Contr.

Spudding Date **8-7-54**

Drlg. Data **Medicine Lodge Pool**

8" @ 280 drlg. 1915

79

County Barber State Kansas

Sec. 3 (Blk. 33 (Sur. Rge.) 13W Map No.

Operator G-M-R Oil

Well No. 1 Farm H. V. Magnison

Elev. 1687 Location C NW SE



660 Ft. From N Line SE

660 Ft. From W Line Quarter

1st. Report AUG 25 1954

Completion

Remarks Medicine Lodge Pool

G-M-R - Contr.

Spudding Date 8-7-54

Drlg. Data D & A TD 3909

8" @ 280 Elgin sd. 3651 DST 3820-75

open 1 hr. Rec. 50' mud 550#

DST 3872-94 open 1 hr. gas in 11 min.

76,000 cfg Rec. 330' gcsw 855#

Heeb. 3810 Doug. 3821 Doug. sd. 3838

DST 3892-3909 open 1 hr. Rec. 480' sw

1140# TD 3909

D & A

FABEN GILSTRAP