


Barber

Section 9 Township 33 Range 13-W

Well No. #1 Thompson "D"

Company Barbara Oil

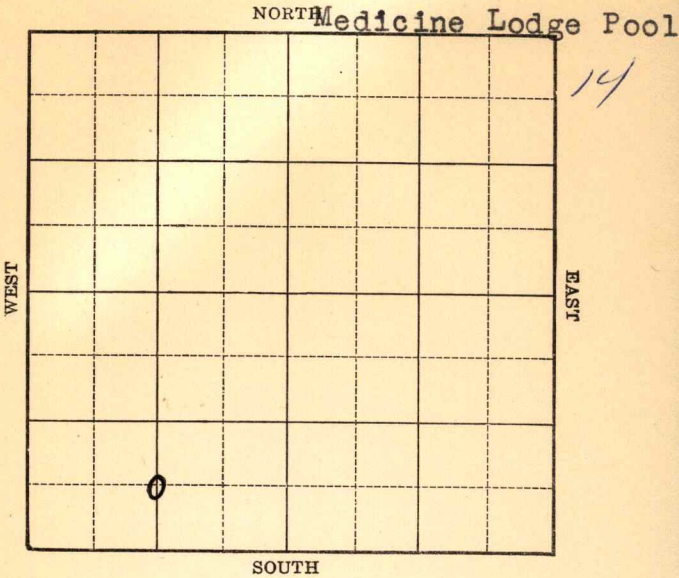

KANSAS


Barber

Sec. 9 Twp. 33 R. 13-WWell No. #1 Thompson "D" Farm

Barbara Oil

Company

(Medicine Lodge)

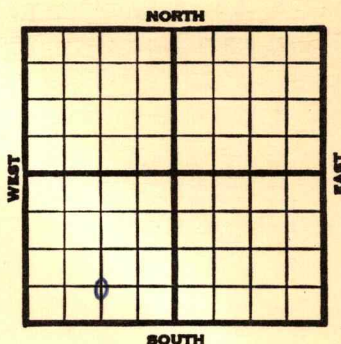 Ft. from N. Line660 Ft. from S. Line Ft. from E. Line1320 Ft. from W. Line

Elev. 1863

REPORT

1940

1/17 Location

1/25 Derrick.

2/1 Surface hole.

2/8 10" - 321' Drlg. 1770'

2/15 Drlg. 2760'

2/23 Topeka 3340' Drlg. 3510'

2/29 Lans. 4060' Drlg. 4065'

3/8 Miss. 4602' 4660' run 6".

No shows.

3/14 7" - 4696' TD. RUST.

3/21 Miss. 4696' Bailing.

3/28 Gas 4735-4743' T.D.

Estimated 75 M gas.

Shut down.

4/4 " "

4/12 " "

4/18 " "

4/25 " "

5/2 " "

5/9 " "

5/16 " "

5/23 " "

OVER

1940

5/29 Shut down.
TD 4743'

6/6 " "

6/13 " "

6/19 Miss. 4696'

7" - 4696'

T.D. 4743'

~~XXX~~ 31 M cu. ft. gas.

COMPLETED

Map No. 93 Sec. 9 Twp. 33 R. 13WWell No. 1 Thompson "D"

Barbara Oil


Company

Contractor

FIRST REPORT

C S $\frac{1}{2}$ SW

SECTION PLAT

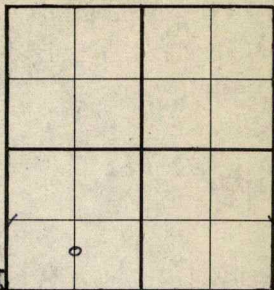

Ft. from N. Line

660

Ft. from S. Line

Ft. from E. Line

1320

Ft. from W. Line

MEDICINE LODGE POOL

Location X

RECORD

Cased _____ in., _____ ft.

Sand _____

Gas _____

Oil _____

Total Depth _____

Rig up _____

Drilling and Remarks:

PRODUCTION

1st 24 hrs. Nat. _____

1st 24 hrs. after shot _____

Gas _____ Cu. Ft.

Dry Hole _____

Abandoned _____

Date

JAN 17 1940

19

S. J. LEWIS

Scout

Map No. 93 Sec. 9 Twp. 33 R. 13^WWell No. 1 Thompson "D"Barbara Oil

Company


Contractor

COMPLETEDC S $\frac{1}{2}$ SW

_____ Ft. from N. Line

660 Ft. from S. Line

_____ Ft. from E. Line

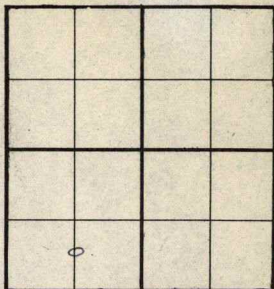1320 Ft. from W. Line**SECTION PLAT**Medicine Lodge Pool

Location _____

Rig up _____

Drilling and Remarks:

*Miss 4696**7" @ 4696**31A1 Gas***RECORD**

Cased _____ in., _____ ft.

Sand _____

Gas _____

Oil _____

Total Depth 4743**PRODUCTION**

1st 24 hrs. Nat. _____

1st 24 hrs. after shot _____

Gas _____ Cu. Ft.

Dry Hole _____

Abandoned _____

Date

JUN 19 1940 19S. J. LEWIS Scout