

Barber


KANSAS

FORM 51 5M 2-38 TPCO.

Section 14 Township 33 Range 13-W

Well No. 2 Magnison

Company Barbara Oil & Gas

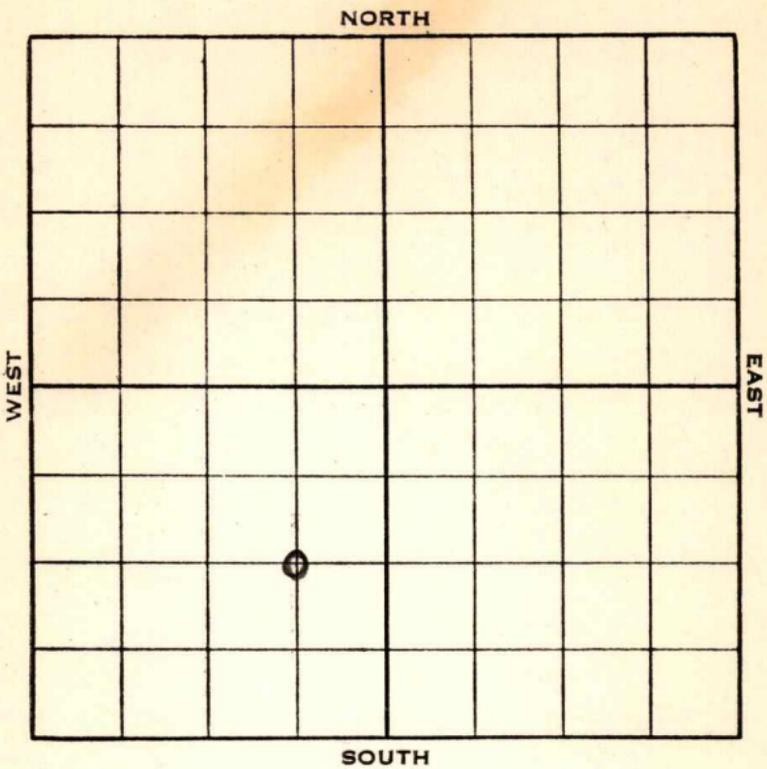

Sec. **14** Twp. **33** R. **13-W**

Well No. **#2 Magnison** Farm


**Barbara Oil & Gas** Company

\_\_\_\_\_ Ft. from N. Line

**1320** Ft. from S. Line

**660** Ft. from E. Line

\_\_\_\_\_ Ft. from W. Line

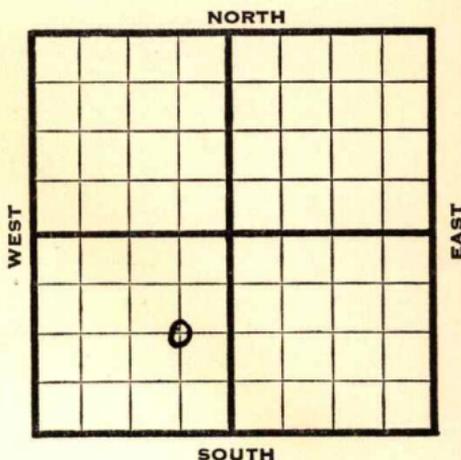

**Elev. 1581**

1938	REPORT
10/12	Location
10/21	Cellar.
10/28	"
11/4	"
11/12	"
11/18	10" - 277'. WOC.
11/25	Drlg. 2425'.
12/2	Drlg. 3345'.
12/9	K. C. 3905'. Drlg. 4000'.
12/15	Chat. 4440'. 7" - 4440' T. D.
	RUST.
12/23	Drlg. cement.
12/30	Drlg. 4700'. No gas.

**OVER**

1939

1/4

Chat. 4440'.

7" - 4440'.

Viola 4816'.

T. D. 4827'.

No oil, gas or water.

**ABANDONED**

Barber **KANSAS**

Map No. 93 Sec. 14 Twp. 33 R. 13W

Well No. 2 Magnison

Barbara Oil & Gas Company

Contractor

**FIRST REPORT**

C  $E\frac{1}{2}$  SW

         Ft. from N. Line

1320 Ft. from S. Line

660 Ft. from E. Line

         Ft. from W. Line

**SECTION PLAT**

	●		

Location X

Rig up         

Drilling and Remarks:

**RECORD**

Cased          in.,          ft.

Sand         

Gas         

Oil         

Total Depth         

**PRODUCTION**

1st 24 hrs. Nat.         

1st 24 hrs. after shot         

Gas          Cu. Ft.

Dry Hole         

Abandoned         

Date

OCT 12 1938 19

H. D. Hatfield Scout

Barber

**KANSAS**

Map No. 93 Sec. 14 Twp. 33 R. 13W

Well No. 2 Magnison

Barbara Oil & Gas Company

Contractor

ABANDONED

C  $E\frac{1}{2}$  SW

\_\_\_\_\_ Ft. from N. Line

1320 Ft. from S. Line

660 Ft. from E. Line

\_\_\_\_\_ Ft. from W. Line

**SECTION PLAT**


**MEDICINE LODGE, POOL**

Location \_\_\_\_\_

Rig up \_\_\_\_\_

Drilling and Remarks:

*Chat 4440*

*7" 4440*

*Viola 4816*

*T.D. 4827*

*No oil, gas or WT*

*D & A*

**RECORD**

Cased \_\_\_\_\_ in., \_\_\_\_\_ ft.

Sand \_\_\_\_\_

Gas \_\_\_\_\_

Oil \_\_\_\_\_

Total Depth \_\_\_\_\_

**PRODUCTION**

1st 24 hrs. Nat. \_\_\_\_\_

1st 24 hrs. after shot \_\_\_\_\_

Gas \_\_\_\_\_ Cu. Ft.

Dry Hole \_\_\_\_\_

Abandoned \_\_\_\_\_

Date

JAN 4 - 1939 19

H. D. Hatfield Scout