

Barker


KANSAS

Section 15 Township 33 Range 13-W

Well Number 1 Holmes "A"

Company Barbara Oil

SPECIAL

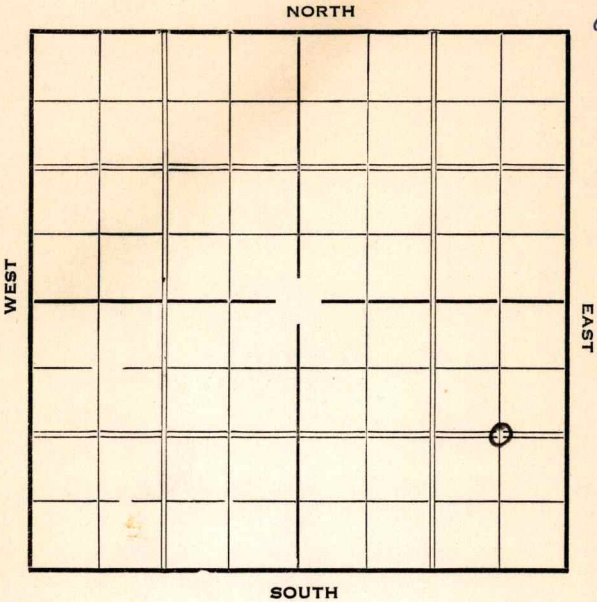

SOUTH

O.W.D.D

1937

3/25 Flowed 30 bbls.
1½ hrs. 10 M gas. Shut down
4/2 " " " " " "
4/8 " " " " " " 2"

4/14 Viola 4845'.
T.D. 4847'.
Flow potential 441 oil.
1 M gas.
34 gravity.

COMPLETED

1937

O. W. D. D

7/7 Old T.D. 4847'.
5" @ 4840'.
C.O. to cement pipe.
7/16 " " " "
7/23 T.D. 4851'. Flowed 1012 bbls
oil 48 hrs.
7/30 " "
8/6 " "
8/13 " "
8/20 " "

8/25 TD 4851 OTD 4847'
Deepened 4'
Pot 763'
Flowing

COMPLETED

KANSASMap No. 93 Sec. 15 Twp. 33 R. 13W.Well No. 1 Holmes.Barbara Oil Company

Contractor

Special**SECTION PLAT**1320 Ft. from N. Line

_____ Ft. from S. Line

660 Ft. from E. Line

_____ Ft. from W. Line

FIRST REPORT

Location ✓

Rig up _____

Drilling and Remarks:

RECORD

Cased _____ in., _____ ft.

Sand _____

Gas _____

Oil _____

Total Depth _____

PRODUCTION

1st 24 hrs. Nat. _____

1st 24 hrs. after shot _____

Gas _____ Cu. Ft.

Dry Hole _____

Abandoned _____

Date

DEC 9 1936

19

S. J. LEWIS

Scout

Barber **KANSAS**Map No. *93* Sec. *15* Twp. *33* R. *13^W*Well No. *1-B.E. Holmes "A"**Barbera Oil* Company

Contractor

COMPLETED**SECTION PLAT**

1320 Ft. from N. Line

_____ Ft. from S. Line

660 Ft. from E. Line

_____ Ft. from W. Line

Location _____

Rig up _____

Drilling and Remarks:

*OWDD**Q.T.O. 4847**deepened 4'**Pot - 763**flowing*

Date

RECORD

Cased _____ in., _____ ft.

Sand _____

Gas _____

Oil _____

Total Depth *4851***PRODUCTION**

1st 24 hrs. Nat. _____

1st 24 hrs. after shot _____

Gas _____ Cu. Ft.

Dry Hole _____

Abandoned _____

*AUG 25 1937**H. D. Hatfield* Scout

KANSAS

Barber

Map No. 95 Sec. 15 Twp. 33 R. 13WWell No. 1 HolmesBarbara Oil

Company

Contractor

SECTION PLAT

			0

1320 Ft. from N. Line

_____ Ft. from S. Line

660 Ft. from E. Line

_____ Ft. from W. Line

COMPLETED

Location _____

Rig up _____

Drilling and Remarks:

Viola 4845.Flow Potential441 Oil 1M Gas34 gravity

RECORD

Cased _____ in., _____ ft.

Sand _____

Gas _____

Oil _____

Total Depth 4842

PRODUCTION

1st 24 hrs. Nat. _____

1st 24 hrs. after shot _____

Gas _____ Cu. Ft.

Dry Hole _____

Abandoned _____

Date

APR 14 1937 19S. J. LEWIS Scout

Barber KANSAS

Map No. _____ Sec. 15 Twp. 33 R. 13^wWell No. 1-HolmesBarbara Oil

Company _____

Contractor _____

FIRST REPORT

SECTION PLAT

1320 Ft. from N. Line

_____ Ft. from S. Line

660 Ft. from E. Line

_____ Ft. from W. Line

			0

Location _____

RECORD

Cased _____ in., _____ ft.

Sand _____

Gas _____

Oil _____

Total Depth _____

PRODUCTION

1st 24 hrs. Nat. _____

1st 24 hrs. after shot _____

Gas _____ Cu. Ft.

Dry Hole _____

Abandoned _____

Date

JUL 7 1937 19

H. D. Hatfield Scout

Rig up _____

Drilling and Remarks:

OWDD -

O.T.O. 4847

5" 4840

C.O. To Cement Pipe

Barber KANSASMap No. 93 Sec. 15 Twp. 33 R. 13 ^WWell No. 1-Holmes "A"*Barbara Oil* Company

Contractor

CORRECTION

1320 Ft. from N. Line

_____ Ft. from S. Line

660 Ft. from E. Line

_____ Ft. from W. Line

SECTION PLAT

Location _____

Rig up _____

Drilling and Remarks:

*First reported**as #1-Holmes*

RECORD

Cased _____ in., _____ ft.

Sand _____

Gas _____

Oil _____

Total Depth _____

PRODUCTION

1st 24 hrs. Nat. _____

1st 24 hrs. after shot _____

Gas _____ Cu. Ft.

Dry Hole _____

Abandoned _____

Date

JUL 14 1937

19

H. D. Hatfield

Scout