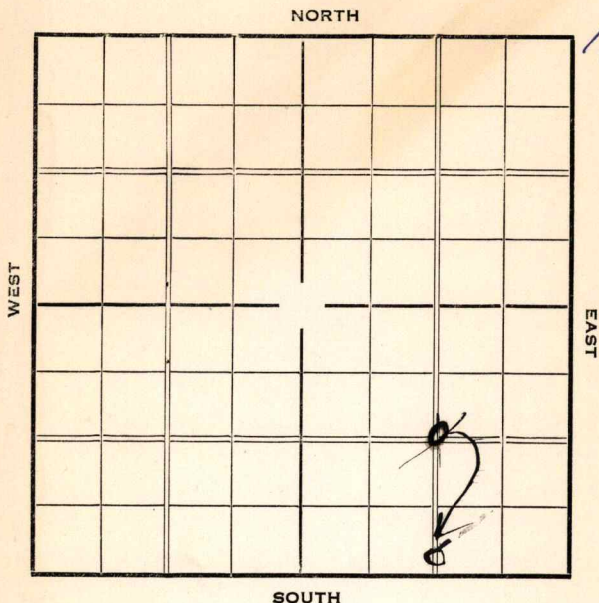


Section 15 Township 33 Range 13-WWell Number 2 - Holmes "A"Company Barbara Oil

Sec. 15 Twp. 33 R. 13-WWell No. #2 Holmes "A" FarmBarbara Oil

Company

Ft. from N. Line

440


Ft. from S. Line

1320

Ft. from E. Line

1320

Ft. from W. Line

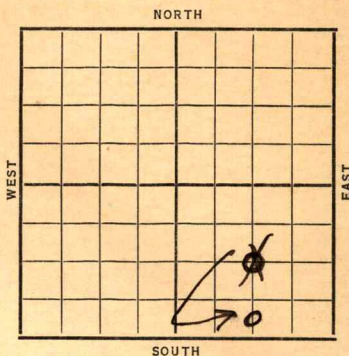

Date	REPORT
1937	
7/14	Cellar
7/23	B. R. R.
7/30	13" @ 274'. Drlg. 800'.
8/6	Drlg. 2325'.
8/13	Drlg. 3170'.
8/20	Drlg. 3820'.
8/28	K.C. 3984'. Oswego 4440'.
	Drlg. 4453'.
9/3	Drlg. 4835'.
9/10	Viola & 7" @ 4839'. C.O.
	No shows rep.
9/17	Chat 4530'. T.D. 4912'.
	No shows.
	Perforated pipe 4565-4611'.
	Est. 6 M gas.
9/24	No test.
10/2	" "
10/8	" "
	OVER

1937

10/13 Chat 4530'.

T.D. 4912'.

Perforated with 50 shots 4565-4611'.

6 M gas.

COMPLETED

Barber KANSAS

Map No. _____ Sec. 15 Twp. 33 R. 13 W.Well No. 2 - Holmes "A"Barbara Oil Company

Contractor _____


FIRST REPORT

SECTION PLAT

_____ Ft. from N. Line

1320 Ft. from S. Line1320 Ft. from E. Line

_____ Ft. from W. Line

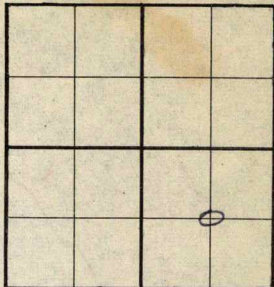

Location _____

Rig up _____

Drilling and Remarks:

Cellar

RECORD

Cased _____ in., _____ ft.

Sand _____

Gas _____

Oil _____

Total Depth _____

PRODUCTION

1st 24 hrs. Nat. _____

1st 24 hrs. after shot _____

Gas _____ Cu. Ft.

Dry Hole _____

Abandoned _____

Date

JUL 1 - 1937H. D. Hatfield Scout

Barber **KANSAS**Map No. 93 Sec. 15 Twp. 33 R. 13^wWell No. 2-Holmes "A"Barbara Oil Company

Contractor


CORRECTION

_____ Ft. from N. Line

440 Ft. from S. Line1320 Ft. from E. Line

_____ Ft. from W. Line

SECTION PLAT

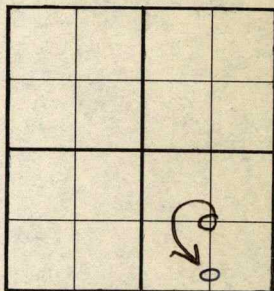

Location _____

Rig up _____

Drilling and Remarks:

*1st reported as
located in the
C SE*

RECORD

Cased _____ in., _____ ft.

Sand _____

Gas _____

Oil _____

Total Depth _____

PRODUCTION

1st 24 hrs. Nat. _____

1st 24 hrs. after shot _____

Gas _____ Cu. Ft.

Dry Hole _____

Abandoned _____

Date

JUL 21 1937 19

H. D. Hatfield

Scout

Map No. 73 Sec. 15 Twp. 33 R. 13WWell No. 2 Holmes "A"Barbara Oil

Company

Contractor

COMPLETED

C S L SE

Ft. from N. Line

440 Ft. from S. Line1320 Ft. from E. Line

Ft. from W. Line

SECTION PLAT

			0

Location _____

Rig up _____

Drilling and Remarks:

RECORD

Cased _____ in., _____ ft.

~~Sand~~ Chat 4530

Gas _____

Total Depth 4912

PRODUCTION

1st 24 hrs. Nat. _____

1st 24 hrs. after shot _____

Gas _____ Cu. Ft.

Dry Hole _____

Abandoned _____

Date

OCT 13 1937

19

H. D. Hatfield

Scout

Per-Forated w/ 50 shots
4565-4611

6 M. gas