




Barber

Map No. KANSAS Sec. 17 Twp. 33 R. 13W

Well No. 3- Lytle Farm \_\_\_\_\_  
Barbara Oil Company \_\_\_\_\_

NORTH

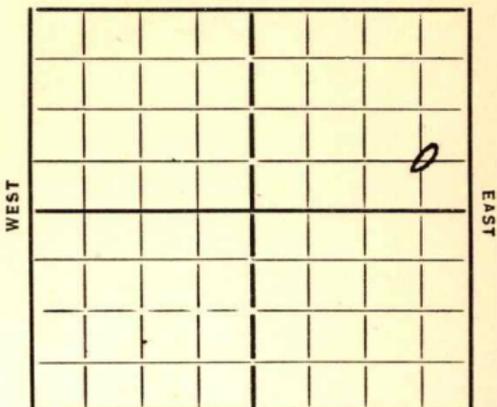

SOUTH

\_\_\_\_\_ Ft. from N. Line

660 Ft. from S. Line

660 Ft. from E. Line

\_\_\_\_\_ Ft. from W. Line

REPORT

Date

1935  
3/27 Moving In  
4/4 Bldg.  
4/11 Rgn  
4/18 15" 18" WOC  
4/26 log 1995  
5/2 dly 2610  
5/9 \_\_\_\_\_  
5/16 dly 3655  
5/23 " 4022 KC 3880  
5/29 " 4480  
6/6 Chat 4505 Cum 8"  
         so 3520-38  
6/13 Rust  
6/20 dly plug  
6/28 17m Gas No Oil dly 4587  
7/3 ~~\_\_\_\_\_ 7/11~~  
7/18 4680 TML 4699 PB 4572  
         2000 acid  
7/24 T7 4699 PB 4577  
         2000 acid 4 1/2 m Gas.

COMPLETED

KANSAS

Map No. 93 Sec. 12 Twp. 33 R. 13W

Well No. 3 - Lytle

Barbara oil Company

Contractor

FIRST REPORT

SECTION PLAT

Ft. from N. Line

660 Ft. from S. Line

660 Ft. from E. Line

Ft. from W. Line

			0

Location

Rig up

Drilling and Remarks:

*moving in*

RECORD

Cased in, ft.

Sand

Gas

Oil

Total Depth

PRODUCTION

1st 24 hrs. Nat.

1st 24 hrs. after shot

Gas Cu. Ft.

Dry Hole

Abandoned

Date

3-27-35 192

ORVAL MANNSCHRECK

Scout

Map No. 93 Sec. 12 Twp. 23 R. 13W

Well No. 3 Lytle

Barber Oil Company

Contractor

COMPLETED

SECTION PLAT

..... Ft. from N. Line

660 Ft. from S. Line

660 Ft. from E. Line

..... Ft. from W. Line

			0

Location.....

Rig up.....

Drilling and Remarks:

P.B. 4577  
2000 acid  
4 1/2 M Gas

RECORD

Cased..... in., ..... ft.

Sand.....

Gas 4 1/2 M

Oil.....

Total Depth 4699

PRODUCTION

1st 24 hrs. Nat.....

1st 24 hrs. after shot.....

Gas..... Cu. Ft.

Dry Hole.....

Abandoned.....

Date

7/24/35 192.....

ORVAL MANSCHRECK

Scout