


Map No. Kansas Sec. 13 Twp. 33 R. 13^w
 Well No. 1 Alexander Farm
J. K. D. Straffer Company
Barber Oil Co.

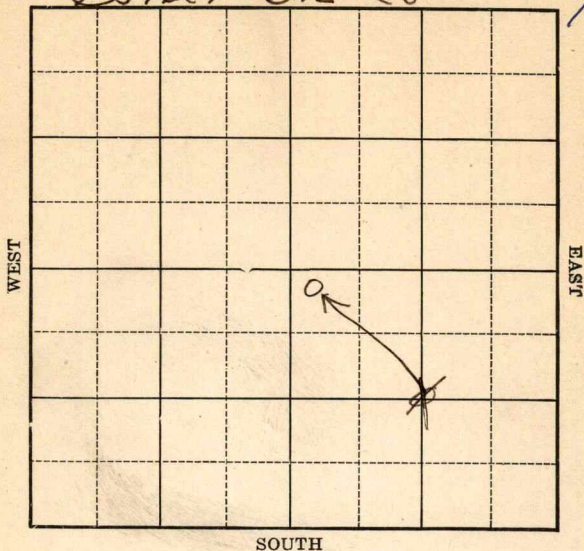

Location _____

Drilling Remarks _____

Rig Up _____

Drilling Remarks _____

RECORD

Cased _____ in. _____ ft.

Sand _____

Gas _____

Oil _____

Total Depth _____

PRODUCTION

1st 24 hrs. Nat. _____

1st 24 hrs. after shot _____

Gas _____ cu. ft.

Dry Hole _____

Abandoned _____

Barber


Map No. Kansas Sec. 13 Twp. 33 R. 13^wWell No. 1 Alexander FarmJ. K. D. Shaffer Company

Barber Oil

Ft. from N. Line

1320 Ft. from S. Line1320 Ft. from E. Line

Ft. from W. Line

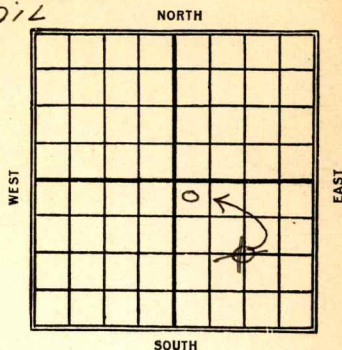

Date	REPORT
1926	
5/26	Rigging up
6/2	Spud
6/9	Drill 275'
6/16	" 400'
6/23	" 620'
6/30	12" at 1375 drilling ahead
7/14	Drill - 1805'
7/22	" 2050
8/11	" 2550
8/18	" 2565' - H.F.W.
8/25	T.D. 2750 - U.P. 8"
9/1	Drill 2900
9/8	" 3110'
9/15	no report
9/22	Drill 3140
9/29	" 3190
10/6	" 3200
10/13	" 3350
10/20	" 3395
10/27	" 3825
11/3	S.D. 4025 - J.D.
11/10	J.D. 4025 S.D.

11/17 - Drlg 4250'

11/24 - T.D. 4250 S.D.

12/1.

12/8 - T.D. 4400' W.R. 5"

12/15 - Run 5" at 4450'

12/21 - no report

12/29 - top line 4480 - 1M gas

1927 1/11 - T.D. 4481

1/6 - top chat 4438 - 4M dry gas
T.D. 4441 S.D. to pull big pipe (tel)

1/14 - sand 4438 - 4447 - estimated
at 5 or 6 m gas - will shut in
for gas well. (tel)

1/19 - Gas sand 4438 - 47

7 M Gas

Map No. **KANSAS** Sec. 13 Twp. 23 R. 10 W

Well No. 1 Alexander

J. K. H. Shaffer Company

Contractor

SECTION PLAT

-----Ft. from N. Line

1320 Ft. from S. Line

1320 Ft. from E. Line

-----Ft. from W. Line

FIRST REPORTS

Location -----

Rig up -----

Drilling and Remarks:

Rigging up.

RECORD

Cased ----- in., ----- ft.

Sand -----

Gas -----

Oil -----

Total Depth -----

PRODUCTION

1st 24 hrs. Nat. -----

1st 24 hrs. after shot -----

Gas ----- Cu. Ft.

Dry Hole -----

Abandoned -----

Date

MAY 26 1926

S. J. LEWIS

----- Scout

Map No. _____ Sec. 13 Twp. 33 R. 12WWell No. 1 AlexanderBarter Oil Company

Contractor

SECTION PLAT

		0	

300 Ft. from N. Line

_____ Ft. from S. Line

_____ Ft. from E. Line

300 Ft. from W. LineCorrection

Location _____

Rig up _____

Drilling and Remarks:

I reported this
in @ of S E.
should be NW.
SE.

they are going
to call it the

Date J. H. Shaffer.

RECORD

Cased _____ in., _____ ft.

Sand _____

Gas _____

Oil _____

Total Depth _____

PRODUCTION

1st 24 hrs. Nat. _____

1st 24 hrs. after shot _____

Gas _____ Cu. Ft.

Dry Hole _____

Abandoned _____

Barter Oil instead of
S. J. Lewis

JUN 2 - 1926

S. J. LEWIS

Scout

Map No. **KANSAS** Sec. *13* Twp. *33* R. *13W*Well No. *1 Alexander**Barter Oil* Company

Contractor

SECTION PLAT

300 Ft. from N. Line

Ft. from S. Line

Ft. from E. Line

300 Ft. from W. Line

		O	

COMPLETED

Location

Rig up

Drilling and Remarks:

Gas Sand
4438 & 4447
*TII 4447**7M. Gas.*

RECORD

Cased _____ in., _____ ft.

Sand _____

Gas _____

Oil _____

Total Depth _____

PRODUCTION

1st 24 hrs. Nat. _____

1st 24 hrs. after shot _____

Gas _____ Cu. Ft.

Dry Hole _____

Abandoned _____

Date

JAN 19 1927

192

S. J. LEWIS

Scout

MAP No. 95 KANSAS SEC. 13 TWP. 33S R. 13W

WELL No. Alexander

Shaffer COMPANY

CONTRACTOR

SECTION PLAT

		0	

ABANDONED

_____ FT. FROM N. LINE

_____ FT. FROM S. LINE

_____ FT. FROM E. LINE

_____ FT. FROM W. LINE

LOCATION _____

RIG UP _____

DRILLING AND REMARKS:

4444-47
4m gas
Wall
don't cover

RECORD

CASED _____ IN. _____ FT.

SAND _____

GAS _____

OIL _____

TOTAL DEPTH 4447

PRODUCTION

1ST 24 HRS. NAT. _____

1ST 24 HRS. AFTER SHOT _____

GAS 4m CU. FT.

DRY HOLE _____

ABANDONED _____

DATE

1/19 1929

SCOUT