


Section 13 Township 33 Range 13-W

Well Number #2 Alexander

Company Barbara O & G

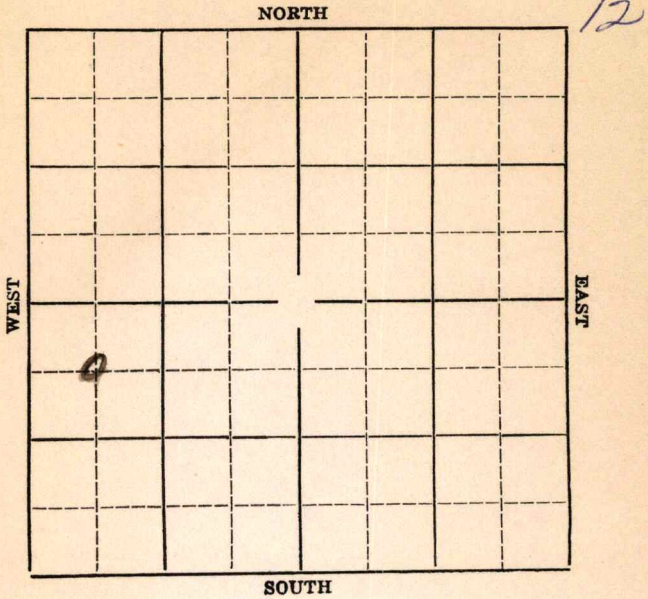

Barber

Map No. **KANSAS** Sec. **13** Twp. **33** R. **13W**

Well No. **#2 Alexander** Farm

Barbara Oil & Gas. Company


660' Ft. from N. Line

_____ Ft. from S. Line

_____ Ft. from E. Line

660' Ft. from W. Line

Elev. 1546

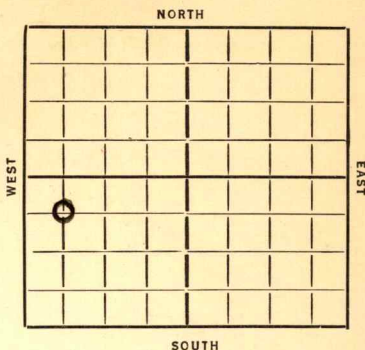

Date
1936

REPORT

6/24 Cellar

7/2 Building rig.

7/9 Rigging up.

7/16 --

7/23 Drlg. 980'.

7/30 Drlg. 2485'.

8/6 Drlg. 2960'.

8/13 Kansas City 3900'. Drlg. 4250'.

8/20 Base KC 4095'. Oswego 4340'. Chat 4410'. 7" @ 4410'. Rust.

8/27 --

9/2/36-Chat 4410'.

Gas 4425-26'.

T.D. 4503'.

2 million cuft of gas.

COMPLETED

Map No. 93 Sec. 13 Twp. 33 R. 13W

Well No. 2 Alexander

Barbara O & G Company

Contractor

SECTION PLAT

0			

660 Ft. from N. Line

6 Ft. from S. Line

_____ Ft. from E. Line

660 Ft. from W. Line

FIRST REPORT

Location _____

Rig up _____

Drilling and Remarks:

Cellar

RECORD

Cased _____ in., _____ ft.

Sand _____

Gas _____

Oil _____

Total Depth _____

PRODUCTION

1st 24 hrs. Nat. _____

1st 24 hrs. after shot _____

Gas _____ Cu. Ft.

Dry Hole _____

Abandoned _____

Date

JUN 24 1936

19

S. J. LEWIS

Scout

KANSAS

Map No. 93 Sec. 13 Twp. 23 R. 13W

Well No. 2 Alexander

Barbara Oil Company

Contractor

SECTION PLAT

0			

660 Ft. from N. Line

_____ Ft. from S. Line

_____ Ft. from E. Line

660 Ft. from W. Line

COMPLETED

Location _____

Rig up _____

Drilling and Remarks:

Chas 4410

Gas 4425-26

2 M Gas

RECORD

Cased _____ in., _____ ft.

Sand _____

Gas _____

Oil _____

Total Depth 4503

PRODUCTION

1st 24 hrs. Nat. _____

1st 24 hrs. after shot _____

Gas _____ Cu. Ft.

Dry Hole _____

Abandoned _____

Date

SEP 2 1936 19

S. J. LEWIS Scout