

Barber


KANSAS

FORM 51 5M 2-38 TPCO.

Section 14 Township 33 Range 13-W

Well No. #3 Angel

Company Barbara Oil & Gas

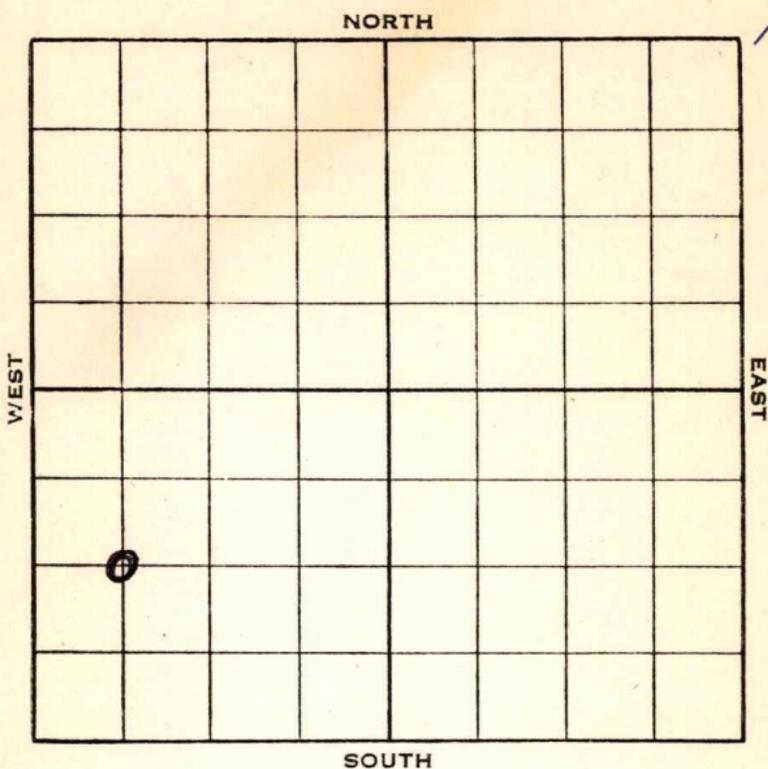

Sec. 14 Twp. 33 R. 13-W

Well No. #3 Angel Farm


Barbara Oil & Gas Company

\_\_\_\_\_ Ft. from N. Line

1320 Ft. from S. Line

\_\_\_\_\_ Ft. from E. Line

660 Ft. from W. Line

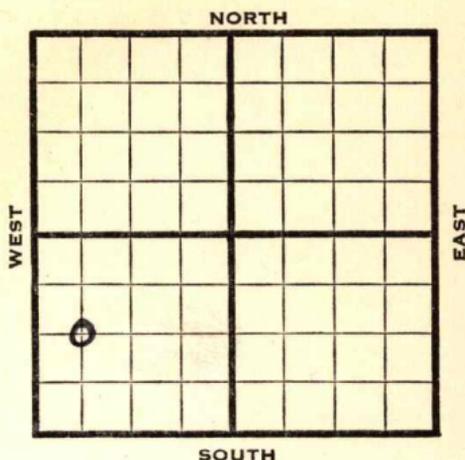

**Elev. 1619**

1938	REPORT
7/6	Cellar.
7/15	10" - 280'. WOC.
7/22	Dlg. 2210'.
7/29	Topeka 3160'. Dlg. 3425'.
8/5	K. C. 3945'. Dlg. 4175'.
8/12	Chat 4485'. S.G. 4490-4555'. Miss. 4665-4705'. T. D. 4800'. Rng. 6".
8/19	6" - 4802' T. D. RUST.
8/26	Viola 4856'. Simp. sand 4978'. T. D. 4980'. No oil. 200' water 3 hrs. Will P. B.
9/2	" " " " "
9/7	Sylvan 4954'. T. D. 4954'. P. B. 4876'. Perforated at 4515-70'. 14 M gas.
	<b>COMPLETED</b>

Map No. 93 Sec. 14 Twp. 33 R. 13W

Well No. 3 Angel

Barbara Oil & Gas Company

Contractor

**FIRST REPORT**

**C W<sup>1</sup>/<sub>2</sub> SW**

         Ft. from N. Line

1320 Ft. from S. Line

         Ft. from E. Line

660 Ft. from W. Line

**SECTION PLAT**


Location                                 

Rig up                                 

Drilling and Remarks:

**CELLAR**

**RECORD**

Cased          in.,          ft.

Sand                                 

Gas                                 

Oil                                 

Total Depth                         

**PRODUCTION**

1st 24 hrs. Nat.                         

1st 24 hrs. after shot                     

Gas                                  Cu. Ft.

Dry Hole                                 

Abandoned                                 

Date

JUL 6 - 1938

19

H. D. Hatfield Scout

Map No. 93 Sec. 14 Twp. 33 R. 13W

Well No. 3 Angel

Barbara Oil & Gas Company

Company

Contractor

COMPLETED

SECTION PLAT

C  $W\frac{1}{2}$  SW

\_\_\_\_\_ Ft. from N. Line

1320 Ft. from S. Line

\_\_\_\_\_ Ft. from E. Line

660 Ft. from W. Line


Location \_\_\_\_\_

Rig up \_\_\_\_\_

Drilling and Remarks:

*P.B. 4876  
perforated at  
4515-70*

*14m gas*

RECORD

Cased \_\_\_\_\_ in., \_\_\_\_\_ ft.

Sand *Sylvan 4954*

Gas \_\_\_\_\_

Oil \_\_\_\_\_

Total Depth 4954

PRODUCTION

1st 24 hrs. Nat. \_\_\_\_\_

1st 24 hrs. after shot \_\_\_\_\_

Gas \_\_\_\_\_ Cu. Ft.

Dry Hole \_\_\_\_\_

Abandoned \_\_\_\_\_

Date

SEP 7 - 1938 19

ORVAL MANNSCHRECK  
Scout