

# KANSAS


Barber

FORM 51 5M BR1X

Section 17 Township 33 Range 13W

Well No. #3, Wilson

Company Barbara Oil

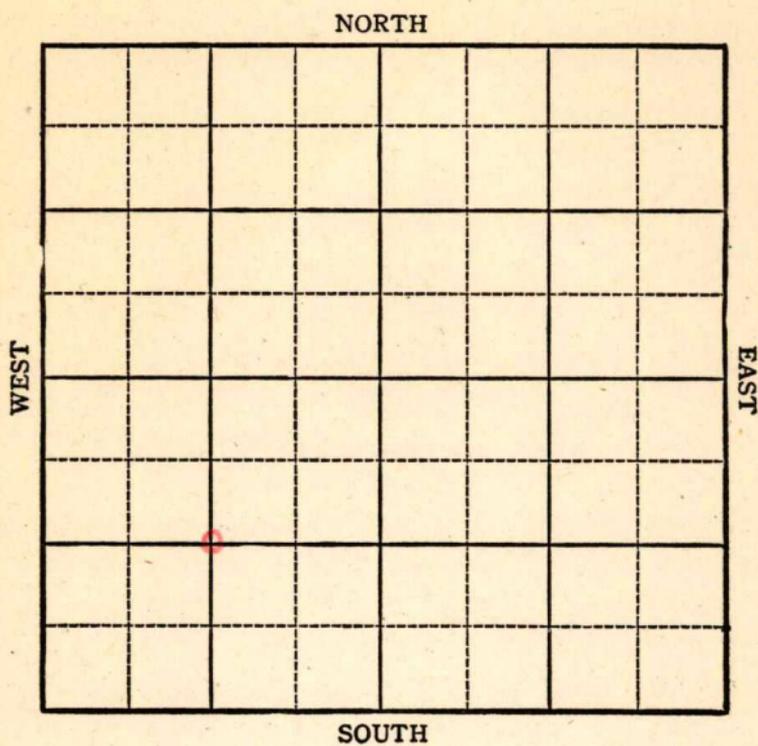

**KANSAS**

Barber

Sec. 17 Twp. 33 R. 13W

Well No. #3, Wilson Farm

Barbara Oil Company

Medicine Lodge.


1320 Ft. from N. Line

\_\_\_\_\_ Ft. from S. Line

\_\_\_\_\_ Ft. from E. Line

1320 Ft. from W. Line

*Elev. 1830*

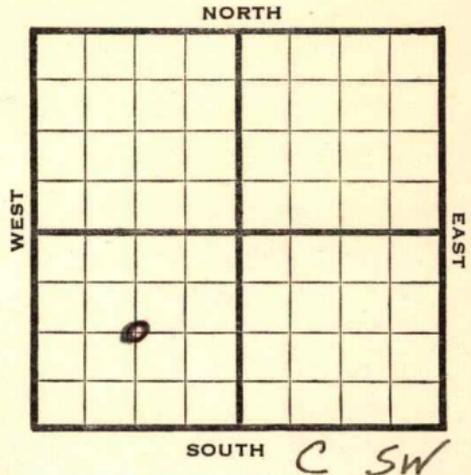

1944

REPORT

- 5/31 Location
- 6/7 "
- 6/15 Derrick
- 6/21 "
- 6/28 "
- 7/12 10" @ 299 Drlg 2400
- 7/19 **Topeka 3300**  
Drlg 3460
- 7/26 Drlg. 4475
- 8/2 Drlg. 4925
- 8/9 **Lans 4176**  
**Miss. 4712**  
**Viola 5026**  
TD 5034 7" @ 5028 RUST
- 8/16 TD 5038
- 8/23 Drlg. 5054
- 8/30 **Viola 5026**  
TD 5070

**ABANDONED**

**KANSAS**

Pool Name Medicine Lodge

Map No. 93 Sec. 17 Twp. 33 R. 13W

Well No. 3 Wilson

Barbara Oil Company

FIRST REPORT Contractor

0 SW


**SECTION PLAT**

1320 Ft. from N. Line

\_\_\_\_\_ Ft. from S. Line

\_\_\_\_\_ Ft. from E. Line

1320 Ft. from W. Line

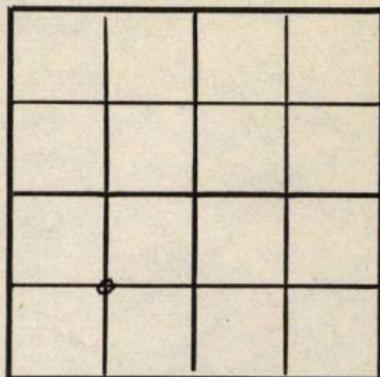

Barber County

Location X

Rig up \_\_\_\_\_

Drilling and Remarks:

**RECORD**

Cased \_\_\_\_\_ in., \_\_\_\_\_ ft.

Sand \_\_\_\_\_

Gas \_\_\_\_\_

Oil \_\_\_\_\_

Total Depth \_\_\_\_\_

**PRODUCTION**

1st 24 hrs. Nat. \_\_\_\_\_

1st 24 hrs. after shot \_\_\_\_\_

Gas \_\_\_\_\_ Cu. Ft.

Dry Hole \_\_\_\_\_

Abandoned \_\_\_\_\_

Date

MAY 3 1 1944 19 \_\_\_\_\_

S. J. LEWIS Scout

Pool Name Medicine Lodge

Map No. 92 Sec. 17 Twp. 33 R. 13W Pool 1

Well No. 3 Wilson

Barbara Oil Company

**ABANDONED**

Contractor

C SW


SECTION PLAT

1320 Ft. from N. Line

\_\_\_\_\_ Ft. from S. Line

\_\_\_\_\_ Ft. from E. Line

1320 Ft. from W. Line

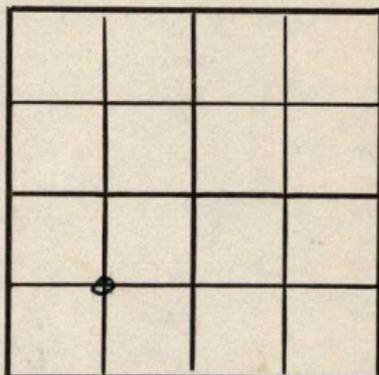

Barber County

Location \_\_\_\_\_

Rig up \_\_\_\_\_

Drilling and Remarks:

*Wid 5026*

RECORD

Cased \_\_\_\_\_ in., \_\_\_\_\_ ft.

Sand \_\_\_\_\_

Gas \_\_\_\_\_

Oil \_\_\_\_\_

Total Depth 5070

PRODUCTION

1st 24 hrs. Nat. \_\_\_\_\_

1st 24 hrs. after shot \_\_\_\_\_

Gas \_\_\_\_\_ Cu. Ft.

Dry Hole \_\_\_\_\_

Abandoned \_\_\_\_\_

Date

AUG 3 0 1944 19

S. J. LEWIS Scout