


Section 19 Township 33 Range 13-W

Well No. #1 Mark \_\_\_\_\_

Company Barbara Oil

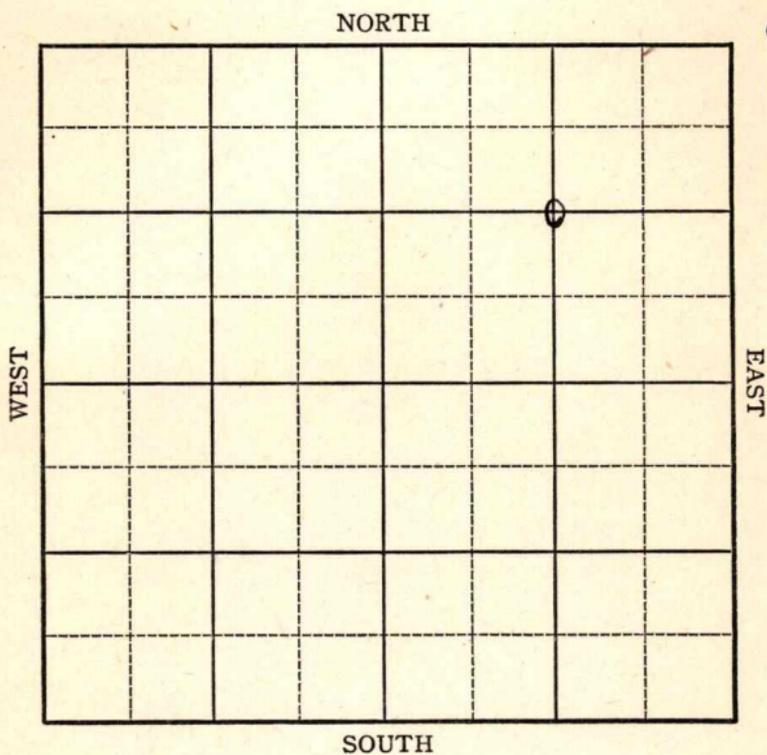

Sec. 19 Twp. 33 R. 13-W

Well No. #1 Mark Farm \_\_\_\_\_

**Barbara Oil** Company \_\_\_\_\_


1320 Ft. from N. Line

Ft. from S. Line

1320 Ft. from E. Line

Ft. from W. Line

*Elev. 1740*

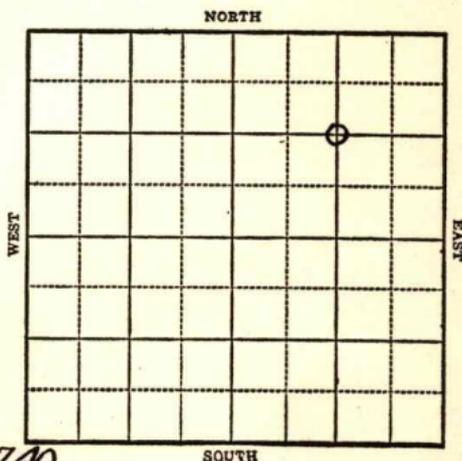

1943

**R E P O R T**

5/19

10" - 300'

**Lans. 4098**

Drlg. 4251'

5/26

**Miss. Chat 4835**

**B. Chat 4869**

T.D. 4887'

7" @ 4887'

RUST

6/2

"

6/9

**Viola 4949**

Drlg. 5010'

6/16

**Simp. 5072**

T.D. 5085'

No shows.

**ABANDONED**

Barber

**KANSAS**

Map No. 93 Sec. 19 Twp. 33 R. 13W

Well No. 1 Mark

Barbara Oil Company

FIRST REPORT Contractor

C NE


**SECTION PLAT**

1320 Ft. from N. Line

\_\_\_\_\_ Ft. from S. Line

1320 Ft. from E. Line

\_\_\_\_\_ Ft. from W. Line

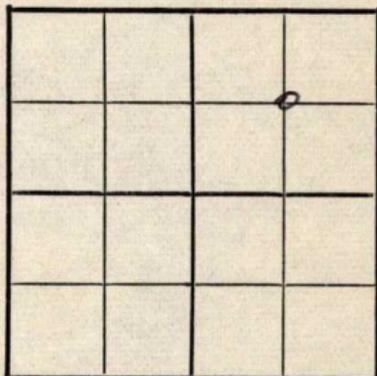

**MEDICINE LODGE POOL**

Location \_\_\_\_\_

Rig up \_\_\_\_\_

Drilling and Remarks:

10" - 300'

Dr lg. 4251'

Lans. 4098'

**RECORD**

Cased \_\_\_\_\_ in., \_\_\_\_\_ ft.

Sand \_\_\_\_\_

Gas \_\_\_\_\_

Oil \_\_\_\_\_

Total Depth \_\_\_\_\_

**PRODUCTION**

1st 24 hrs. Nat. \_\_\_\_\_

1st 24 hrs. after shot \_\_\_\_\_

Gas \_\_\_\_\_ Cu. Ft.

Dry Hole \_\_\_\_\_

Abandoned \_\_\_\_\_

Date

MAY 1 9 1943

19

S. J. LEWIS

Scout

**KANSAS**

Barber

Map No. 93 Sec. 19 Twp. 33 R. 13W

Well No. 1 Mark

Barbara Oil Company

ABANDONED Contractor

C NE


**SECTION PLAT**

1320 Ft. from N. Line

\_\_\_\_\_ Ft. from S. Line

1320 Ft. from E. Line

\_\_\_\_\_ Ft. from W. Line

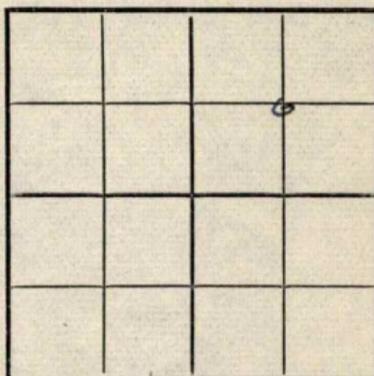

MEDICINE LODGE

Location \_\_\_\_\_

**RECORD**

Rig up \_\_\_\_\_

Cased \_\_\_\_\_ in., \_\_\_\_\_ ft.

Drilling and Remarks:

Sand \_\_\_\_\_

Gas \_\_\_\_\_

Oil \_\_\_\_\_

Total Depth 5085

*Drif 5072*  
*Nochrow*

**PRODUCTION**

1st 24 hrs. Nat. \_\_\_\_\_

1st 24 hrs. after shot \_\_\_\_\_

Gas \_\_\_\_\_ Cu. Ft.

Dry Hole \_\_\_\_\_

Abandoned \_\_\_\_\_

Date

JUN 16 1943 19

S. J. LEWIS Scout