


Section 20 Township 33 Range 13-W

Well No. #1 Wilson "B"

Company Barbara Oil & Gas

Medicine Lodge Pool
NORTH

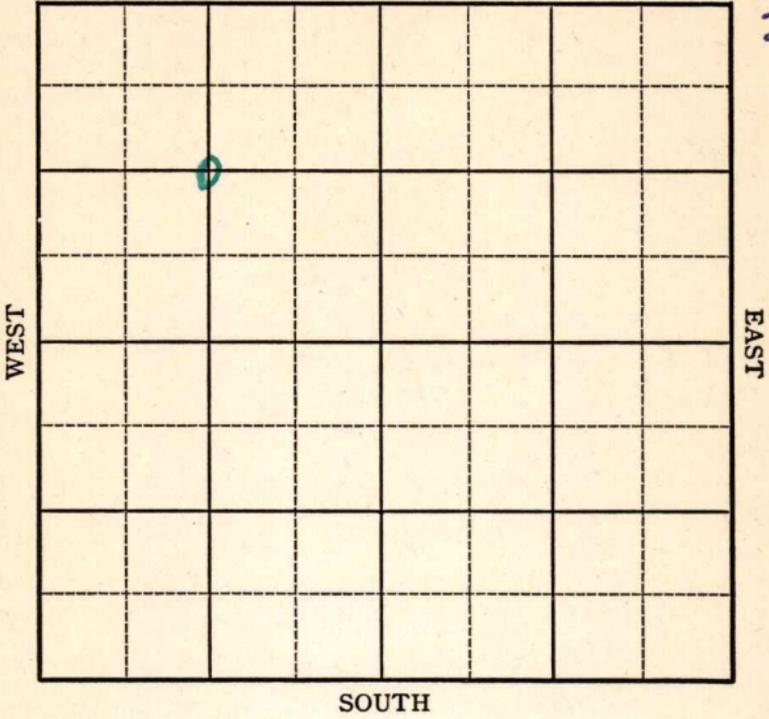

Sec. 20 Twp. 33 R. 13-W

Well No. #1 Wilson "B" Farm

Barbara Oil & Gas Company

(Medicine Lodge)


1320 Ft. from N. Line

Ft. from S. Line

Ft. from E. Line

1320 Ft. from W. Line

Elev. 1706

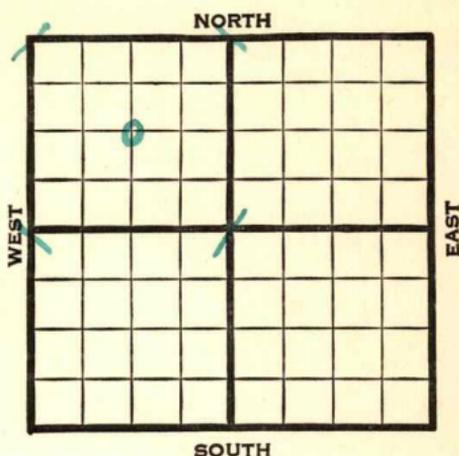

1941	REPORT
10/15	10" - 319' Drlg. 4377'
10/23	K.C. 4048' Miss. 4625' T.D.
	7" - 4623' RUST.
10/30	Fsg. tools.
11/6	" "
11/13	" "
11/20	" "
11/28	" "
12/4	" "
12/10	Miss. 4625'
	7" - 4623'
	T.D. 4652'
	22,842,000 cu. ft. gas.
	ABANDONED

Map No. K-93 Sec. 20 Twp. 33 R. 13W

Well No. 1 Wilson "B"


Barbara Oil & Gas Company

FIRST REPORT

Contractor

C NW
1320 Ft. from N. Line
____ Ft. from S. Line
____ Ft. from E. Line
1320 Ft. from W. Line

SECTION PLAT

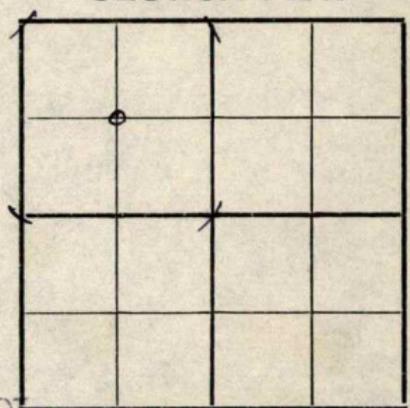

MEDICINE LODGE POOL

Location _____

Rig up _____

Drilling and Remarks:

10" - 319

Drlg. 4377'

RECORD

Cased _____ in., _____ ft.
Sand _____
Gas _____
Oil _____
Total Depth _____

PRODUCTION

1st 24 hrs. Nat. _____
1st 24 hrs. after shot _____
Gas _____ Cu. Ft.
Dry Hole _____
Abandoned _____

Date

OCT 15 1941 19

S. J. LEWIS Scout

Map No. 93 Sec. 20 Twp. 33 R. 13W


Well No. 1 Wilson "B"

Barbara Oil & Gas Company

COMPLETEL Contractor

C NW

SECTION PLAT

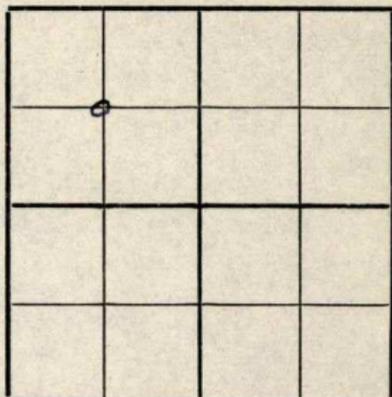

1320 Ft. from N. Line

_____ Ft. from S. Line

_____ Ft. from E. Line

1320 Ft. from W. Line

MEDICINE LODGE POOL

Location _____

Rig up _____

Drilling and Remarks:

Miss 4625

7" @ 4629

22, 842, 000 cu ft

gas

RECORD

Cased _____ in., _____ ft.

Sand _____

Gas _____

Oil _____

Total Depth 4652

PRODUCTION

1st 24 hrs. Nat. _____

1st 24 hrs. after shot _____

Gas _____ Cu. Ft.

Dry Hole _____

Abandoned _____

Date

DEC 1 0 1941

19

S. J. LEWIS Scout