


Section 15 Township 33 Range 13-W

Well No. 3 Holmes "A"

Company Barbara Oil

NORTH Medicine Lodge Pool

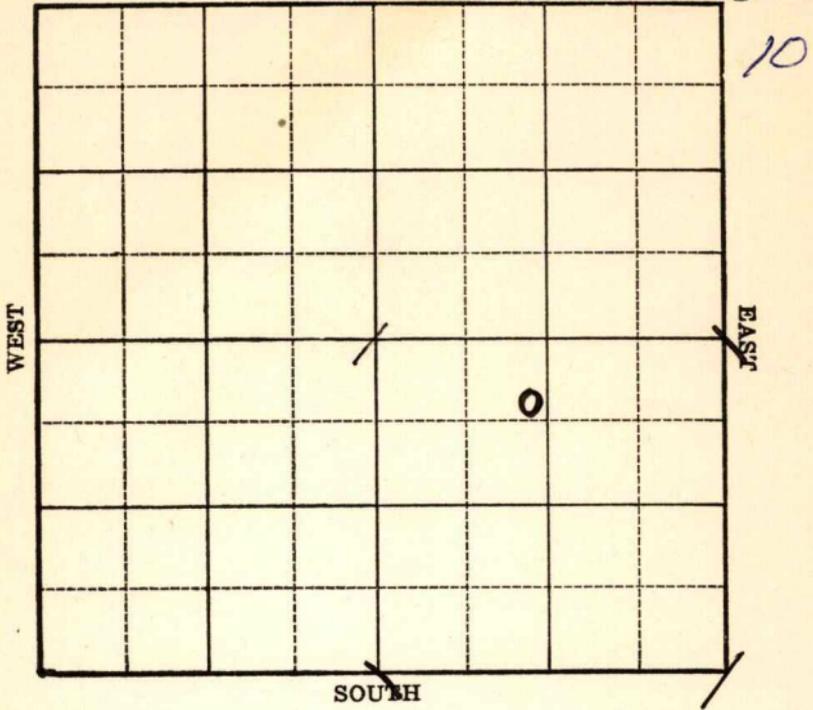

**KANSAS**

Barber

Sec. 15 Twp. 33 R. 13-W

Well No. #3 Holmes "A" Farm \_\_\_\_\_

Barbara Oil Company \_\_\_\_\_

(Medicine Lodge)


445 Ft. from N. Line

\_\_\_\_\_ Ft. from S. Line

1400 Ft. from E. Line

\_\_\_\_\_ Ft. from W. Line

**Elev. 1660**

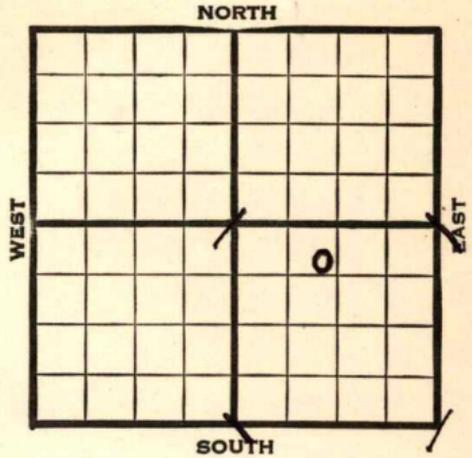

1939	REPORT
5/17	Cellar.
5/26	Rotary.
6/1	10" - 286' Drlg. 2075'
6/8	Drlg. 3310'
6/16	<b>Lans. 3986'</b> Drlg.
6/23	<b>Chat. 4508'</b> <b>Kinderhook 4815'</b> <b>Gas 4560'</b> 7" - 4830' RUST.
6/29	Bailing mud.
7/6	<b>Misener 4858'</b> T.D. 4868' Flow 45 bbls. per hour 8 hrs. 1 1/2 M gas. No water.
7/13	" " " "
7/19	<b>Misener 4858'</b> 7" - 4830' T.D. 4868' Potential 551 bbls., flow.
	<b>COMPLETED</b>

Map No. 93 Sec. 15 Twp. 33 R. 13W

Well No. 3 Holmes "A"

Barbara Oil

Company

Contractor

FIRST REPORT


SECTION PLAT

C E L N W S E  
445 Ft. from N. Line

\_\_\_\_\_ Ft. from S. Line

1400 Ft. from E. Line

\_\_\_\_\_ Ft. from W. Line

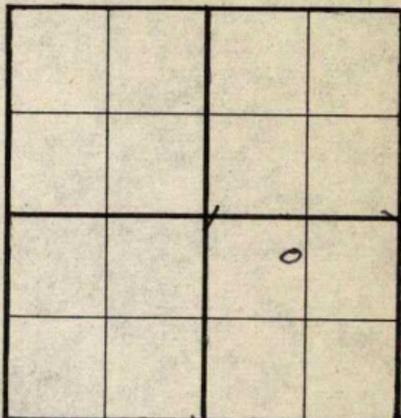

MEDICINE LODGE POOL

Location \_\_\_\_\_

Rig up \_\_\_\_\_

Drilling and Remarks:

**Cellar**

RECORD

Cased \_\_\_\_\_ in., \_\_\_\_\_ ft.

Sand \_\_\_\_\_

Gas \_\_\_\_\_

Oil \_\_\_\_\_

Total Depth \_\_\_\_\_

PRODUCTION

1st 24 hrs. Nat. \_\_\_\_\_

1st 24 hrs. after shot \_\_\_\_\_

Gas \_\_\_\_\_ Cu. Ft.

Dry Hole \_\_\_\_\_

Abandoned  \_\_\_\_\_

Date

MAY 17 1939 19

S. J. LEWIS

Scout

Map No. 93 Sec. 15 Twp. 33 R. 13W

Well No. 3 Holmes "A"

Barbara Oil Company

Contractor

COMPLETED

SECTION PLAT

C E L N W S E

445 Ft. from N. Line

\_\_\_\_\_ Ft. from S. Line

1400 Ft. from E. Line

\_\_\_\_\_ Ft. from W. Line


MEDICINE LODGE POOL

Location \_\_\_\_\_

Rig up \_\_\_\_\_

Drilling and Remarks:

*Alumina 4858  
7" @ 4836  
Flow. 551 Bx.*

RECORD

Cased \_\_\_\_\_ in., \_\_\_\_\_ ft.

Sand \_\_\_\_\_

Gas \_\_\_\_\_

Oil \_\_\_\_\_

Total Depth 4868

PRODUCTION

1st 24 hrs. Nat. \_\_\_\_\_

1st 24 hrs. after shot \_\_\_\_\_

Gas \_\_\_\_\_ Cu. Ft.

Dry Hole \_\_\_\_\_

Abandoned \_\_\_\_\_

Date

JUL 19 1939

19

S. J. LEWIS

Scout