

KANSAS

Form 51—5M—7-40—Palace


Barber

Section 15 Township 33 Range 13-W

Well No. #4 ~~#1~~ B. E. Holmes "A"

Company Barbara Oil

NORTH Medicine Lodge

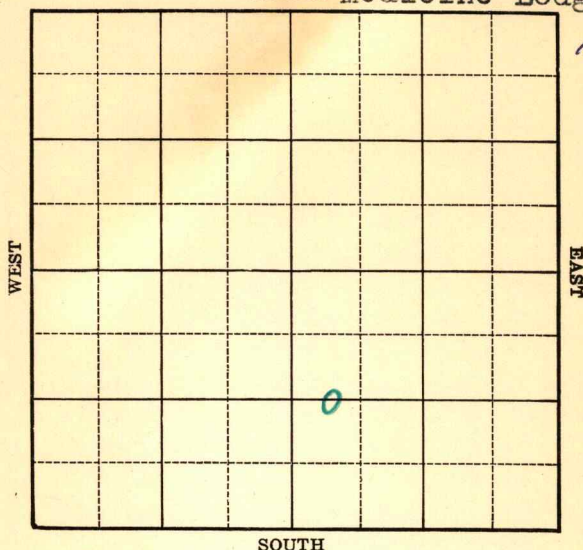

1941

2/12

Viola 4849'

7" - 4828'

T.D. 4870'

72 shots 4553-78'

No shows.

ABANDONED

Map No. 93 Sec. 15 Twp. 33 R. 13WWell No. 1 B. E. Holmes "A"Barbara Oil

Company

FIRST REPORT

Contractor

C W L SE

SECTION PLAT

 Ft. from N. Line1320 Ft. from S. Line Ft. from E. Line440 Ft. from W. Line

MEDICINE LODGE

Location Rig up

Drilling and Remarks:

Cellar

RECORDCased in., ft.Sand Gas Oil Total Depth **PRODUCTION**1st 24 hrs. Nat. 1st 24 hrs. after shot Gas Cu. Ft.Dry Hole Abandoned

Date

NOV 20 1940 19S. J. LEWIS Scout

Map No. 93 Sec. 15 Twp. 33 R. 13WWell No. 4 Holmes "A"Barbara Oil

Company

CORRECTION

Contractor

C W L SE

 Ft. from N. Line1320 Ft. from S. Line Ft. from E. Line440 Ft. from W. Line

SECTION PLAT

MEDICINE LODGE POOL

Location Rig up

Drilling and Remarks:

Reported as

#1 Holmes "A"

RECORD

Cased in., ft.Sand Gas Oil Total Depth

PRODUCTION

1st 24 hrs. Nat. 1st 24 hrs. after shot Gas Cu. Ft.Dry Hole Abandoned

Date

NOV 26 1940

19

S. J. LEWIS

Scout

Map No. 93 Sec. 15 Twp. 33 R. 13WWell No. 4 B.E. Holmes "A"Barbara Oil

Company

Contractor

ABANDONED

C W L SE

SECTION PLAT

 Ft. from N. Line1320 Ft. from S. Line Ft. from E. Line440 Ft. from W. Line

MEDICINE LODGE POOL

Location Rig up

Drilling and Remarks:

*Viola 4849.**7" C 4828.**72 Shot 4553-78**No shows*

RECORD

Cased in., ft.Sand Gas Oil Total Depth 4870

PRODUCTION

1st 24 hrs. Nat. 1st 24 hrs. after shot Gas Cu. Ft.Dry Hole Abandoned

Date

FEB 12 1941

S. J. LEWIS

Scout