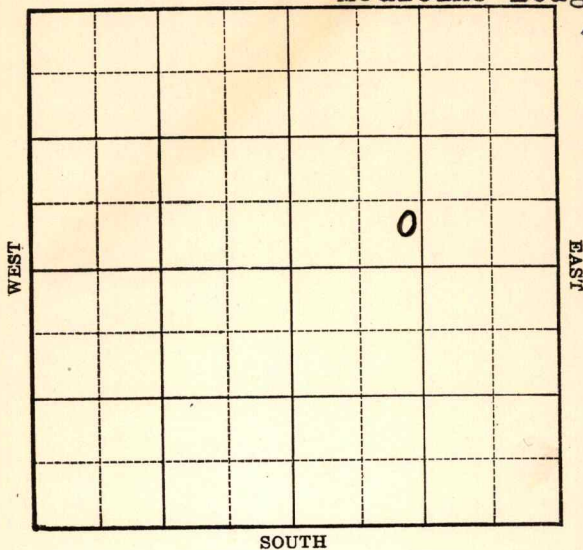


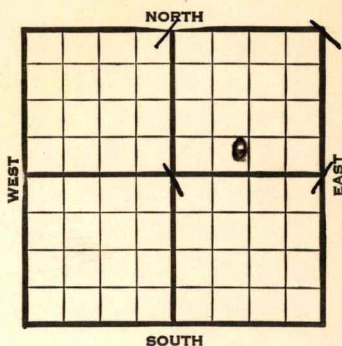
Company Barbara Oil & Gas

NORTH Medicine Lodge Pool



KANSAS

Barber

Sec. 15 Twp. 33 R. 13-WWell No. #3 F. F. Root "B" FarmBarbara Oil & Gas Company
(Medicine Lodge) Ft. from N. Line445 Ft. from S. Line1400 Ft. from E. Line Ft. from W. Line

Elev. 1655

REPORT

1939

7/5 Location

7/13 Rotary.

7/20 10" - 276' Drlg.

7/27 Drlg. 2540'

8/3 Topeka 3140' Drlg. 3525'

8/10 Lans. 3975' Drlg. 4310'

8/17 7" - 4809' Drlg. 4813'

8/24 No report.

8/31 Viola 4863' T.D. 4900'

No shows. P.B. 4600'

25 M gas.

9/6 Viola 4863'

P. B. 4600'

T.D. 4900'

66 shots 4549-79'

25 M cu. ft. gas.

COMPLETED

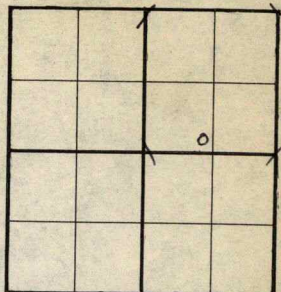
KANSAS

Barber

Map No. 93 Sec. 15 Twp. 33 R. 13WWell No. 3 F. F. Root "B"Barbara Oil & Gas

Company

Contractor

**FIRST REPORT
C S L NE****SECTION PLAT** Ft. from N. Line445 Ft. from S. Line1400 Ft. from E. Line Ft. from W. Line**MEDICINE LODGE POOL**Location XRig up

Drilling and Remarks:

RECORDCased in., ft.Sand Gas Oil Total Depth **PRODUCTION**1st 24 hrs. Nat. 1st 24 hrs. after shot Gas Cu. Ft.Dry Hole Abandoned

Date

JUL 5 1939 19S. J. LEWIS

Scout

Map No. 73 Sec. 15 Twp. 33 R. 13WWell No. 3 F. F. Root "B"Barbara Oil & Gas

Company

Contractor

COMPLETED

SECTION PLAT

C S L N E

Ft. from N. Line

445

Ft. from S. Line

1400

Ft. from E. Line

Ft. from W. Line

MEDICINE LODGE POOL

Location _____

Rig up _____

Drilling and Remarks:

*Viola 4863**P.B 4600**66 Shots 4549-79**25M Gas*

RECORD

Cased _____ in., _____ ft.

Sand _____

Gas _____

Oil _____

Total Depth 4900

PRODUCTION

1st 24 hrs. Nat. _____

1st 24 hrs. after shot _____

Gas _____ Cu. Ft.

Dry Hole _____

Abandoned _____

Date

SEP 6 1939 19

S. J. LEWIS Scout