


Barber

KANSAS

Section 16 Township 33 Range 13-W

Well No. 1 Thompson "B"

Company Barbara Oil

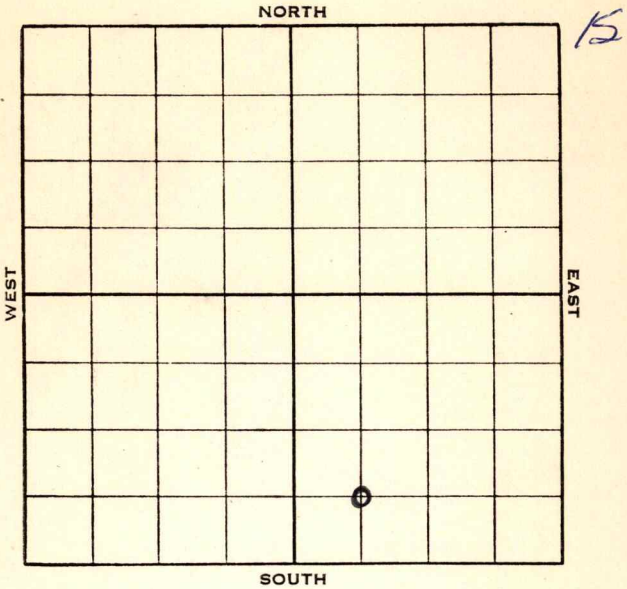

Sec. 16 Twp. 33 R. 13-W

Well No. #1 Thompson "B" Farm


Barbara Oil Company

\_\_\_\_\_ Ft. from N. Line

660 Ft. from S. Line

\_\_\_\_\_ Ft. from E. Line

660 Ft. from W. Line

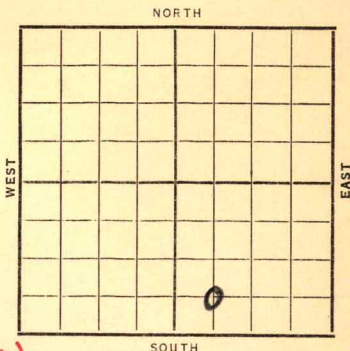

**Elev. 1679 (Est)**

Date	REPORT
1938	
7/20	Location
7/29	Cellar.
8/5	B. R. R.
8/12	R. H.
8/19	10" - 280'. WOC.
8/26	Dlg. 2675'.
9/2	Dlg. 3800'.
9/9	Lansing 4038'. Oswego 4450'.
	Dlg. 4515'.
9/16	Chat 4538'. 7" - 4574'. WOC.
9/21	7" at 4574'.
	Chat 4538'.
	T. D. 4630'.
	35 M gas.
	<b>COMPLETED</b>

Map No. 93 Sec. 16 Twp. 33 R. 13W

Well No. 1 Thompson "B"

Barbara Oil Company

Contractor

**FIRST REPORT**

**C SW SE**

         Ft. from N. Line

660 Ft. from S. Line

         Ft. from E. Line

660 Ft. from W. Line

**SECTION PLAT**

		0	

Location X

Rig up         

Drilling and Remarks:

**RECORD**

Cased          in.,          ft.

Sand         

Gas         

Oil         

Total Depth         

**PRODUCTION**

1st 24 hrs. Nat.         

1st 24 hrs. after shot         

Gas          Cu. Ft.

Dry Hole         

Abandoned         

Date

JUL 20 1938 19 H. D. Hatfield Scout

Map No. 73 Sec. 16 Twp. 33 R. 13W

Well No. 1 Thompson "B"

Barbara Oil Company

Contractor

SECTION PLAT

C SW SE

Ft. from N. Line

660 Ft. from S. Line

Ft. from E. Line

660 Ft. from W. Line

		0	

Location \_\_\_\_\_

Rig up \_\_\_\_\_

Drilling and Remarks:

35 m gas

RECORD

Cased 7 in., 4574 ft.

Sand chat 4538

Gas \_\_\_\_\_

Oil \_\_\_\_\_

Total Depth 4630

PRODUCTION

1st 24 hrs. Nat. \_\_\_\_\_

1st 24 hrs. after shot \_\_\_\_\_

Gas \_\_\_\_\_ Cu. Ft.

Dry Hole \_\_\_\_\_

Abandoned \_\_\_\_\_

Date  
**SEP 21 1938**

19

Natfield  
By: Paul

Scout