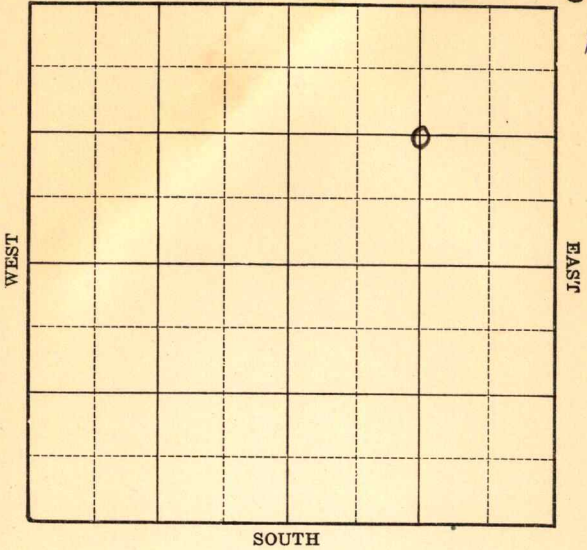


Section 16 Township 33 Range 13-W

Well No. #2 Thompson "B"

Company Barbara O&G

NORTH Medicine Lodge Pool



KANSAS

Barter

Map No. 93 Sec. 16 Twp. 33 R. 19WWell No. 2 Thompson "B"Barbara O. G. Company

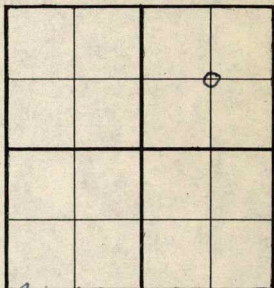
Contractor

CNE

FIRST REPORT

 Ft. from N. Line1320 Ft. from S. Line1320 Ft. from E. Line Ft. from W. Line

SECTION PLAT

Medicine Lodge Pool.Location Rig up

Drilling and Remarks:

Cellar

RECORD

Cased in., ft.Sand Gas Oil Total Depth

PRODUCTION

1st 24 hrs. Nat. 1st 24 hrs. after shot 'Gas Cu. Ft.Dry Hole Abandoned

Date

AUG 30 1939

19

S. J. LEWIS

Scout

Barber

KANSAS

Map No. 93 Sec. 16 Twp. 33 R. 13WWell No. 2 Thompson "B"Barbara Oil & Gas

Company

Contractor

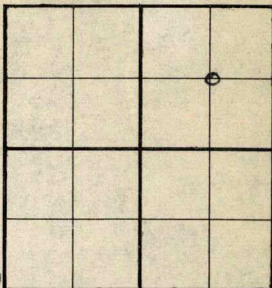
COMPLETED

SECTION PLAT

C NE

 Ft. from N. Line1320 Ft. from S. Line1320 Ft. from E. Line Ft. from W. Line

MEDICINE LODGE POOL

Location

RECORD

Cased in., ft.Sand Gas Oil Total Depth 4958

PRODUCTION

1st 24 hrs. Nat. 1st 24 hrs. after shot Gas Cu. Ft.Dry Hole Abandoned Location Rig up

Drilling and Remarks:

*Virta 4915**7" @ 4860**79 Sh to 4605-74**16 M Gas*

Date

OCT 25 1939

19

S. J. LEWIS

Scout