


Section 19 Township 33 Range 13 W

Well No. #1 Lasswell

Company G*M*R

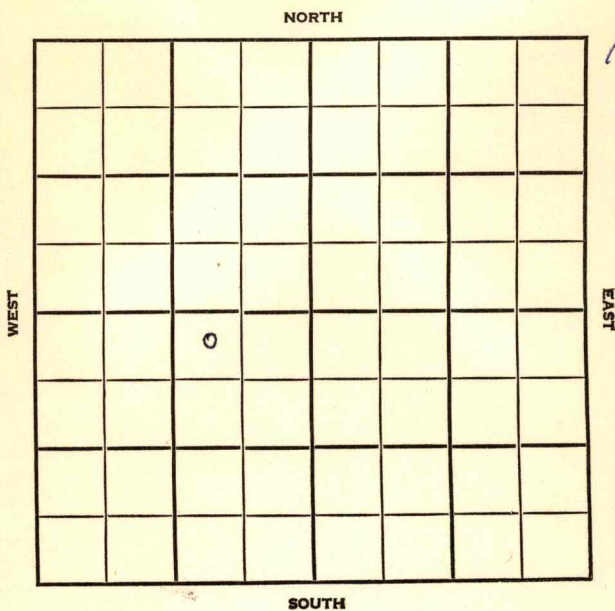

Barber

KANSAS


SEC. 19	TWP. 33	R. 13W
---------	---------	--------

WELL NO. #1 Lass well FARM

COMPANY G-M-R

CONTRACTOR

_____ Ft. from N. Line
 _____ Ft. from S. Line
 _____ Ft. from E. Line
 _____ Ft. from W. Line

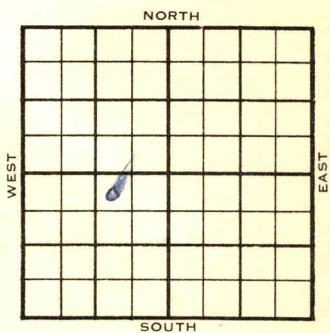

NW NE SW

1955	ELEVATION 1780'	REPORT
------	-----------------	--------

7/27

Comm. 5/6/55
 8 5/8" @260/180 DST 4602-44 open 1 hr.
 gas in 15 min. Rec. 650' oil # DST
 4655-4706 open 1 1/2 hr. Rec. 50' mud 50/
 20" DST 4693-4760 open 1/2 hr. Rec. 20'
 mud 0/30" 5 1/2" @4660.100 48/4605-14
 S/1 boph 2000 A S/4 boph S/2 boph 5000
 A S/4 boph Comp. 75 bopd.

Elg sd.	3809	2029
Orlud	3905	2125
Hb.	3942	2162
Dg	3982	2202
L.	4123	2343
Dg. Sd1	4004	2224
Ce. "arm	4604	2824
M.	4656	2876
TD.	4760	

FIRST REPORT

✓

COMPLETED

County Barber Elev. 1780
 Sec. 19 Twp. 33 Rge. 13W
 Company G-M-R
 Farm Name Lasswell No. 1

TOPS	DEPTH	LOG	DATUM	Loc. in Sec.
Anh.				NW NE SW
Tp. <u>Elg Sd</u>	<u>3809</u>		<u>2029</u>	
H. <u>Orlod</u>	<u>3905</u>		<u>2125</u>	
Fr. <u>Hb</u>	<u>3942</u>		<u>2162</u>	
Dg. <u></u>	<u>3982</u>		<u>2202</u>	
Bl. <u>Dg Sd</u>	<u>4004</u>		<u>2224</u>	
L. <u></u>	<u>4123</u>		<u>2343</u>	
K.C.				Geol.
B.K.C.				Contr.
Ce. <u>Marm</u>	<u>4604</u>		<u>2824</u>	
C. <u></u>				
M. <u></u>	<u>4656</u>		<u>2876</u>	
M. <u></u>				Pool
K. <u></u>				
Mz. <u></u>				
Mq. <u></u>				
V. <u></u>				
S. <u></u>				
S. <u></u>				
A. <u></u>				
R. <u></u>				
Pe. <u></u>				
G. <u></u>				
T.D. <u></u>	<u>4760</u>			

FIRST REPORT
COMPLETE

Date Comm. 5-6-55 JUL 27 1955

8 5/8" @ 260/180 DST 4602-44 open 1 hr
gas in 15 min. Rec. 650' oil 0#
DST 4655-4706 open 1 1/2 hr. Rec. 50' mud
50/20" DST 4693-4760 open 1/2 hr.
Rec. 20' mud 0/30" 5 1/2" @ 4660.100
48/ 4605-14 \$/ 1 boph 2000 A
S/ 4 boph S/ 2 boph 5000 A S/ 4 boph
Comp. 75 bopd