

KANSAS

Barber

FORM 51 5M PETROL


Section 19 Township 33
25 Range 13W

Well No. #1 Ottt "A"

Company Barbara

Medicine Lodge Pool NORTH

//

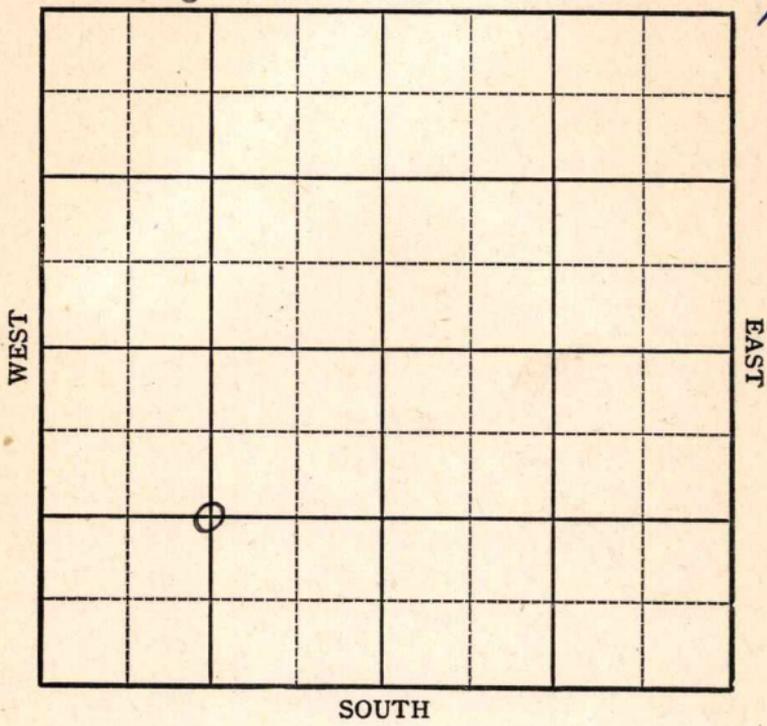


Sec. 19 Twp. 33 R. 13-W


Well No. #1, Ott "A" Farm

Barbara Company

1320

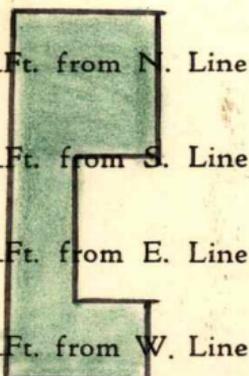

1320

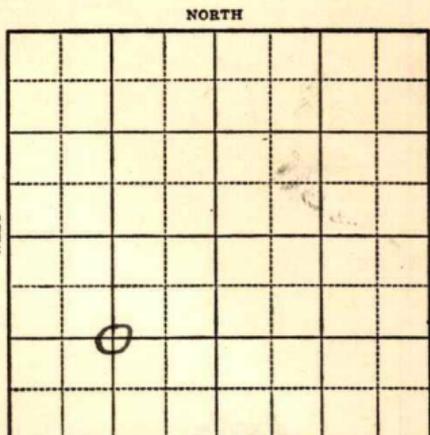

Elev. 1820 SOUTH

R E P O R T

1943
12/15

Cellar

12/22

"

12/29

"

1944

1-5

"

1/12

Derrick

1/19

"

1/26

"

2-2

"

2-9

Drlg. 2650'

2-16

10" at 314'

Topeka 3200'

Drilling 3635'

3/1

Miss 4697

3/8

Drlg. 4850' ⁵⁰³⁷
Viola ~~4926-46~~ TD

5" @ 4946'

Rust.

3/15

113 shots 4695-4760

no gas

SSO 4742-60

3/22

" "

3/29

Viola 5037 Corrected

TD 5084-300 oil in 12 hrs.

OVER

1944

~~4~~/5

Simp 5152

Sand 5173

T~~D~~ 5180

HFW

ABANDONED

KANSAS

Map No. 93 Sec. 19 Twp. 33 R. 13W

Well No. 1 Ott "A"

Barbara

Company

FIRST REPORT

Contractor

C SW


SECTION PLAT

1320 Ft. from N. Line

_____ Ft. from S. Line

_____ Ft. from E. Line

1320 Ft. from W. Line

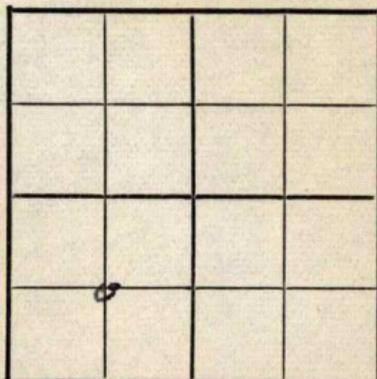

Medicine Lodge Pool

Location _____

Rig up _____

Drilling and Remarks:

Cellar

RECORD

Cased _____ in., _____ ft.

Sand _____

Gas _____

Oil _____

Total Depth _____

PRODUCTION

1st 24 hrs. Nat. _____

1st 24 hrs. after shot _____

Gas _____ Cu. Ft.

Dry Hole _____

Abandoned _____

Date

DEC 15 1943 19

S. J. LEWIS Scout

KANSAS

Map No. 93 Sec. 19 Twp. 33 R. 13W

Well No. 1 Ott "A"

Barbara Company

ABANDONED Contractor

C SW


SECTION PLAT

1320 Ft. from N. Line

_____ Ft. from S. Line

_____ Ft. from E. Line

1320 Ft. from W. Line

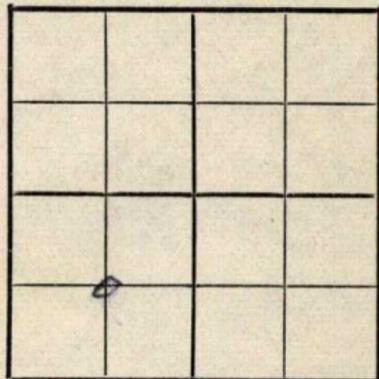

Medicine Lodge Pool

Location _____

Rig up _____

Drilling and Remarks:

*Sump 5152.
Sand 5178
H.P.W.*

RECORD

Cased _____ in., _____ ft.

Sand _____

Gas _____

Oil _____

Total Depth 5180

PRODUCTION

1st 24 hrs. Nat. _____

1st 24 hrs. after shot _____

Gas _____ Cu. Ft.

Dry Hole _____

Abandoned _____

Date

APR 5 1944 19

S. J. LEWIS Scout