

Section 20 Township 33 Range 13-W


Well No. #1 Lasswell

Company Barbara Oil & Gas

Wildcat

NORTH

//

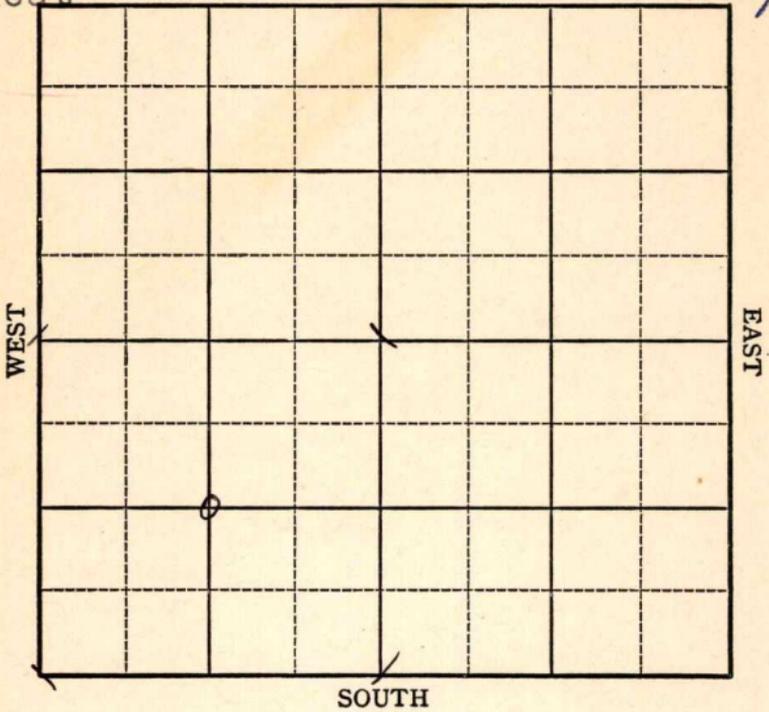

Sec. 20 Twp. 33 R. 13-W

Well No. #1 Lasswell Farm

Barbara Oil & Gas Company

(Wildcat)


_____ Ft. from N. Line

1320 Ft. from S. Line

_____ Ft. from E. Line

1320 Ft. from W. Line

Elev. 1693

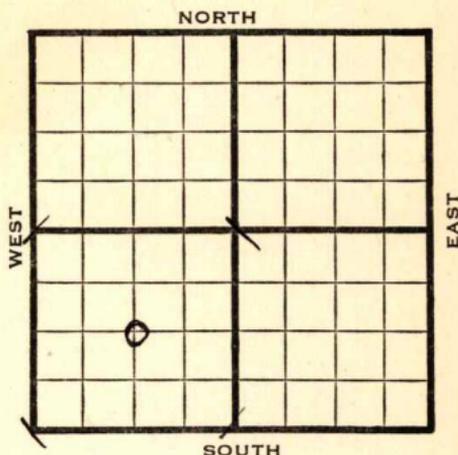

1942

REPORT

8/12	Location (Sinclair Prairie Farmout)
8/19	Derrick
8/27	"
9/2	"
9/9	"
9/16	"
9/23	Drilling 2000'
9/30	Drlg. 2820
10/7	10" - 280 Drlg. 3500'
10/14	KC 4040 BKC 4395 Drlg. 4460'
10/21	" " " " " "
10/28	Chat. 4659 7" - 4705 84 shots 4659-87 22-3/4 M Gas T.D. 4705

COMPLETED

Map No. 93 Sec. 20 Twp. 33 R. 13W

Well No. 1 Lasswell

Barbara Oil & Gas Company

FIRST REPORT Contractor

C SW


SECTION PLAT

_____ Ft. from N. Line

1320 Ft. from S. Line

_____ Ft. from E. Line

1320 Ft. from W. Line

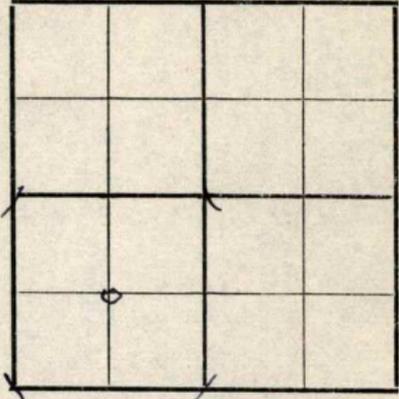

WIL DCA T

Location _____

Rig up _____

Drilling and Remarks:

**Sinclair Prairie
Farmout**

RECORD

Cased _____ in., _____ ft.

Sand _____

Gas _____

Oil _____

Total Depth _____

PRODUCTION

1st 24 hrs. Nat. _____

1st 24 hrs. after shot _____

Gas _____ Cu. Ft.

Dry Hole _____

Abandoned _____

Date

AUG 12 1942 19

S. J. LEWIS Scout