

# KANSAS

Barber


FORM 51 5M 10-41 PETROL

Section 20 Township 33 Range 13-W

Well No. #7 McKee

Company Barbara Oil

Medicine Lodge

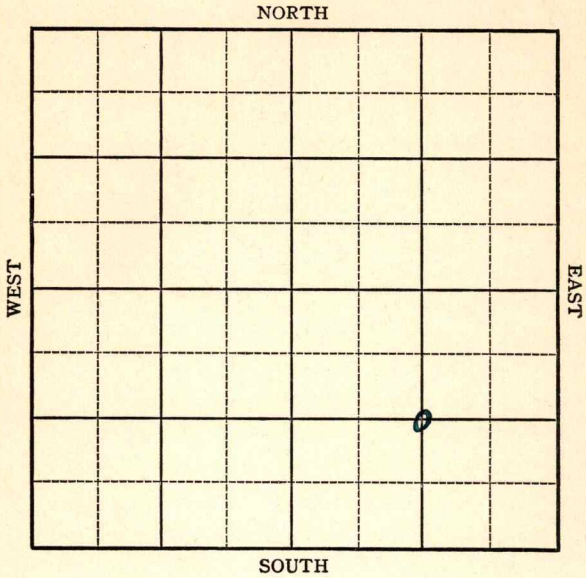

**KANSAS**

**Barber**

Sec. 20 Twp. 33 R. 13-W

Well No. #7 McKee Farm \_\_\_\_\_

Barbara Oil Company


(Medicine Lodge)

1320 Ft. from N. Line

\_\_\_\_\_ Ft. from S. Line

1320 Ft. from E. Line

\_\_\_\_\_ Ft. from W. Line

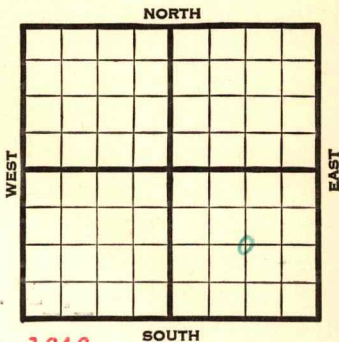

**Elev. 1646**

1941	REPORT
12/17	Location
12/24	Derrick.
12/31	Surface hole.
1942	
1/8	10" - 277' Drlg. 2400'
1/15	Drlg. 3500'
1/22	<b>Lans. 4004'</b>
	T.D. 4115' SD.
1/29	" " "
2/5	" " "
2/12	" " "
2/19	" " "
2/26	" " "
3/5	C. O.
3/12	<b>Miss. 4515'</b> Drlg. 4720'
3/19	<b>Viola 4897'</b> Drlg. 4934'
3/26	T.D. 4992' 7" - 4992' RUST.
4/2	P.B. to 4875' 51 shots 4588 to 4638' Show gas.
4/8	500 acid. 511,000 gas
	<b>OVER</b>

1942  
4/15

Miss. 4515'

Viola 4897'

7" - 4992'

T.D. 4992'

P.B. to 4875'

51 shots 4588-4638'

500 acid.

4 M gas.

COMPLETED

Map No. 93 Sec. 20 Twp. 33 R. 13W

Well No. 7 McKee

Barbara Oil Company

Contractor

FIRST REPORT

C SE


1320 Ft. from N. Line

\_\_\_\_\_ Ft. from S. Line

1320 Ft. from E. Line

\_\_\_\_\_ Ft. from W. Line

SECTION PLAT

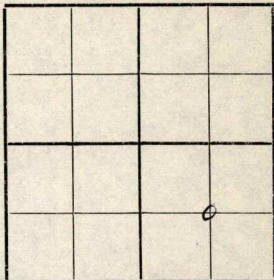

MEDICINE LODGE POOL

Location XX

Rig up \_\_\_\_\_

Drilling and Remarks:

RECORD

Cased \_\_\_\_\_ in., \_\_\_\_\_ ft.

Sand \_\_\_\_\_

Gas \_\_\_\_\_

Oil \_\_\_\_\_

Total Depth \_\_\_\_\_

PRODUCTION

1st 24 hrs. Nat. \_\_\_\_\_

1st 24 hrs. after shot \_\_\_\_\_

Gas \_\_\_\_\_ Cu. Ft.

Dry Hole \_\_\_\_\_

Abandoned \_\_\_\_\_

Date

DEC 17 1941

19

S. J. LEWIS

Scout

Map No. 93 Sec. 20 Twp. 33 R. 13W

Well No. 7 McKee

Barbara Oil Company

**COMPLETED** Contractor

C SE


SECTION PLAT

1320 Ft. from N. Line

\_\_\_\_\_ Ft. from S. Line

1320 Ft. from E. Line

\_\_\_\_\_ Ft. from W. Line

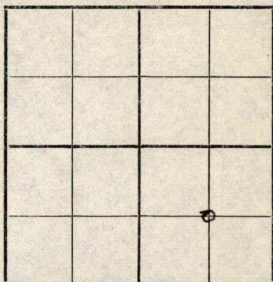

MEDICINE LODGE POOL

RECORD

Location \_\_\_\_\_

Cased \_\_\_\_\_ in., \_\_\_\_\_ ft.

Rig up \_\_\_\_\_

Sand \_\_\_\_\_

Drilling and Remarks:

Gas \_\_\_\_\_

Oil \_\_\_\_\_

*Miss 4515.*

Total Depth 4992

*Virba 4897*

*7" @ 4992*

*PB 4875*

*512 hd to 4588-4638*

PRODUCTION

1st 24 hrs. Nat. \_\_\_\_\_

1st 24 hrs. after shot \_\_\_\_\_

Gas \_\_\_\_\_ Cu. Ft.

Dry Hole \_\_\_\_\_

Abandoned \_\_\_\_\_

Date

APR 15 1942

19

S. J. LEWIS

Scout