


Section 21 Township 33 Range 13-W

Well No. 3 McKee

Company Barbara

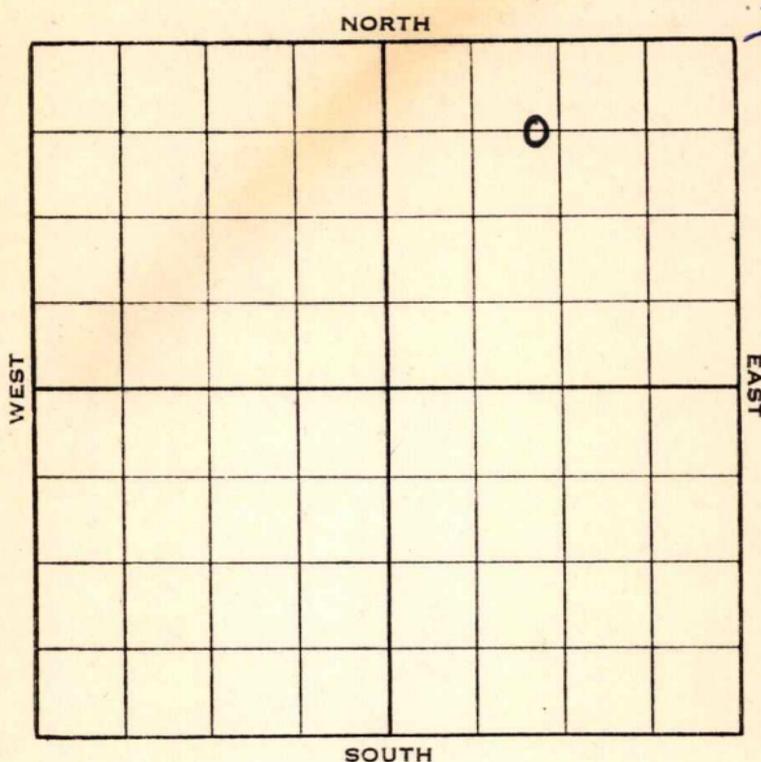

KANSAS

Barber

Sec. 21 Twp. 33 R. 13-W


Well No. #3 McKee Farm _____
Barbara Company _____

660 Ft. from N. Line

_____ Ft. from S. Line

_____ Ft. from E. Line

1200 Ft. from W. Line

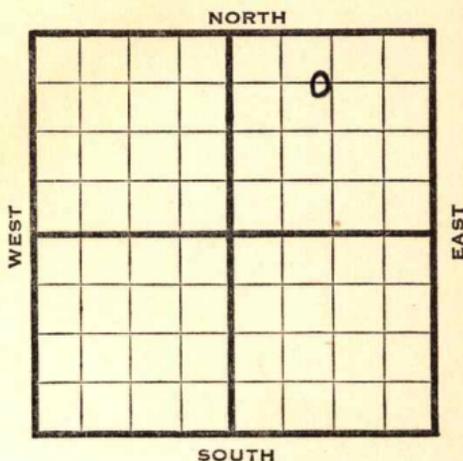

Elev. 1708 1656

1938	REPORT
6/1	Cellar.
6/10	R U R
6/17	12" @ 275'. Drlg. 1825'.
6/24	Drlg. 3010'.
7/1	Drlg. 3875'
7/8	Chat 4547'. 7" - 4550'.
	No shows. RUST.
7/15	" " " "
7/20	7" - 4550'.
	Chat 4547'.
	Pay 4590-4640'.
	T. D. 4643'.
	14 M gas.
	COMPLETED

Map No. 93 Sec. 21 Twp. 33 R. 13W

Well No. 3 McKee

Barbara Company

Contractor

FIRST REPORT

C E L N W N E

SECTION PLAT

660 Ft. from N. Line

_____ Ft. from S. Line

_____ Ft. from E. Line

1200 Ft. from W. Line

		○	

Location _____

RECORD

Rig up _____

Cased _____ in., _____ ft.

Drilling and Remarks:

Sand _____

Cellar

Gas _____

Oil _____

Total Depth _____

PRODUCTION

1st 24 hrs. Nat. _____

1st 24 hrs. after shot _____

Gas _____ Cu. Ft.

Dry Hole _____

Abandoned _____

Date

JUN 1 - 1938 19

H. D. Hatfield Scout

Barber

KANSAS

Map No. 93 Sec. 21 Twp. 33 R. 13W

Well No. 3 McKee

Barbara

Company

Contractor

COMPLETED

C E L NW NE

660 Ft. from N. Line

_____ Ft. from S. Line

_____ Ft. from E. Line

1200 Ft. from W. Line

SECTION PLAT

		0	

Location _____

Rig up _____

Drilling and Remarks:

14 M. 925

RECORD

Cased 7 in., 4550 ft.

Sand Chat 4547

Gas - Pay 4590 - 4640

Oil _____

Total Depth 4643

PRODUCTION

1st 24 hrs. Nat. _____

1st 24 hrs. after shot _____

Gas _____ Cu. Ft.

Dry Hole _____

Abandoned _____

Date

JUL 20 1938 19

H. D. Hatfield

Scout