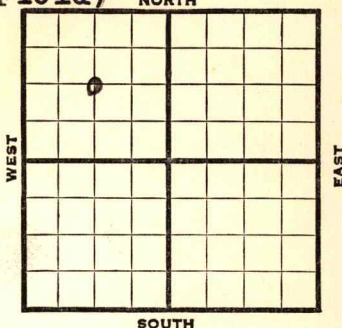


Well No. #5 McGee Farm

Company

NORTH

Elev. 1704'

[illegible]

Map No. 93 Sec. 21 Twp. 33 R. 13WWell No. 5 McKeeBarbara Oil

Company

Contractor

FIRST REPORT

C NW

SECTION PLAT

1320 Ft. from N. Line

_____ Ft. from S. Line

_____ Ft. from E. Line

1320 Ft. from W. Line**MEDICINE LODGE GAS
FIELD**

Location _____

Rig up _____

Drilling and Remarks:

BRR

RECORD

Cased _____ in., _____ ft.

Sand _____

Gas _____

Oil _____

Total Depth _____

PRODUCTION

1st 24 hrs. Nat. _____

1st 24 hrs. after shot _____

Gas _____ Cu. Ft.

Dry Hole _____

Abandoned _____

Date

APR 5 - 1939 19H. D. Hatfield

Scout

Barber

KANSAS

Map No. 93 Sec. 21 Twp. 33 R. 13WWell No. 5 McKeeBarbara Oil


Company

Contractor

COMPLETED

C NW

SECTION PLAT

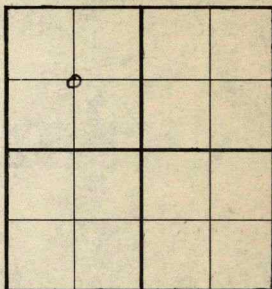1320 Ft. from N. Line Ft. from S. Line Ft. from E. Line1320 Ft. from W. LineMEDICINE LODGE GAS
FIELDLocation Rig up

Drilling and Remarks:

*KC 4072**6 5/8" @ 4580**7M gas*

RECORD

Cased in., ft.Sand Gas Oil Total Depth 4694

PRODUCTION

1st 24 hrs. Nat. 1st 24 hrs. after shot Gas Cu. Ft.Dry Hole Abandoned

Date

MAY 31 1939

19

S. J. LEWIS

Scout