


Section 21 Township 33 Range 13-W

Well No. 1 J. H. McKee

Company Barbara Oil

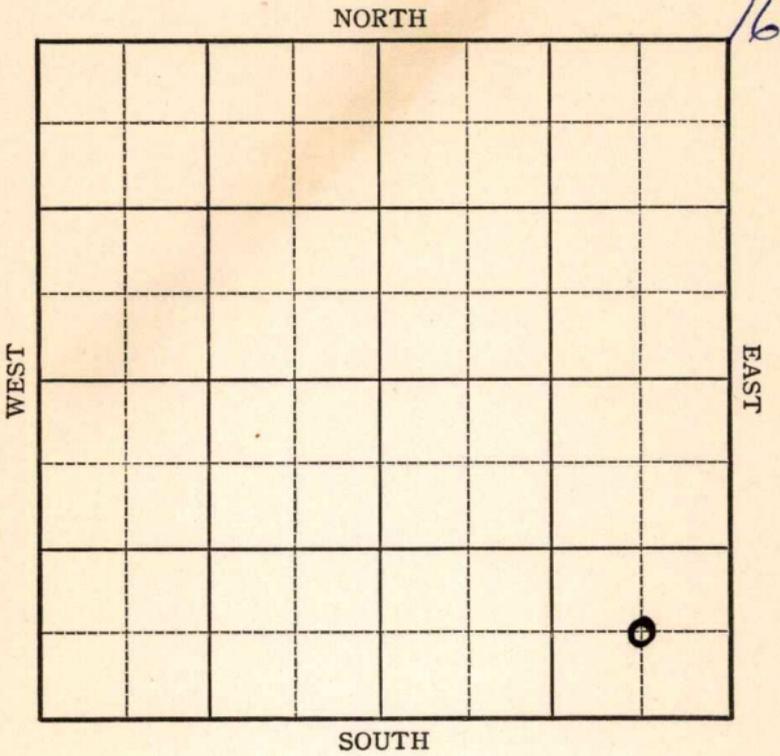

1938

1/12 8" @ 4520'.

Chat 4506'.

T.D. 4635'.

21 M gas.

COMPLETED

KANSAS

Barber

Map No. 93 Sec. 21 Twp. 33 R. 13W

Well No. 1 J H McKee

Barbara Oil

Company

Contractor

FIRST REPORT

SECTION PLAT

C SE SE

 Ft. from N. Line

660 Ft. from S. Line

660 Ft. from E. Line

 Ft. from W. Line

			0

Location

Rig up

Drilling and Remarks:
Cellar

RECORD

Cased in., ft.

Sand

Gas

Oil

Total Depth

PRODUCTION

1st 24 hrs. Nat.

1st 24 hrs. after shot

Gas Cu. Ft.

Dry Hole

Abandoned

Date

H. D. Hatfield

OCT - 6 1937 19

Scout

Barber

KANSAS

Map No. 93 Sec. 21 Twp. 33 R. 13W

Well No. 1 J. H. McKee

Barbara Oil

Company

Contractor

COMPLETED

C SE SE

_____ Ft. from N. Line

660 Ft. from S. Line

660 Ft. from E. Line

_____ Ft. from W. Line

SECTION PLAT

-			0

Location _____

Rig up _____

Drilling and Remarks:

21 M Geo

RECORD

Cased 8 in., 4520 ft.

Sand Chat 4506

Gas _____

Oil _____

Total Depth 4635

PRODUCTION

1st 24 hrs. Nat. _____

1st 24 hrs. after shot _____

Gas _____ Cu. Ft.

Dry Hole _____

Abandoned _____

Date

JAN 12 1938

19

H. D. Hatfield

Scout