


Section 22 Township 33 Range 13-W

Well No. 1 - B. E. Holmes "B"


Company Barbara Oil

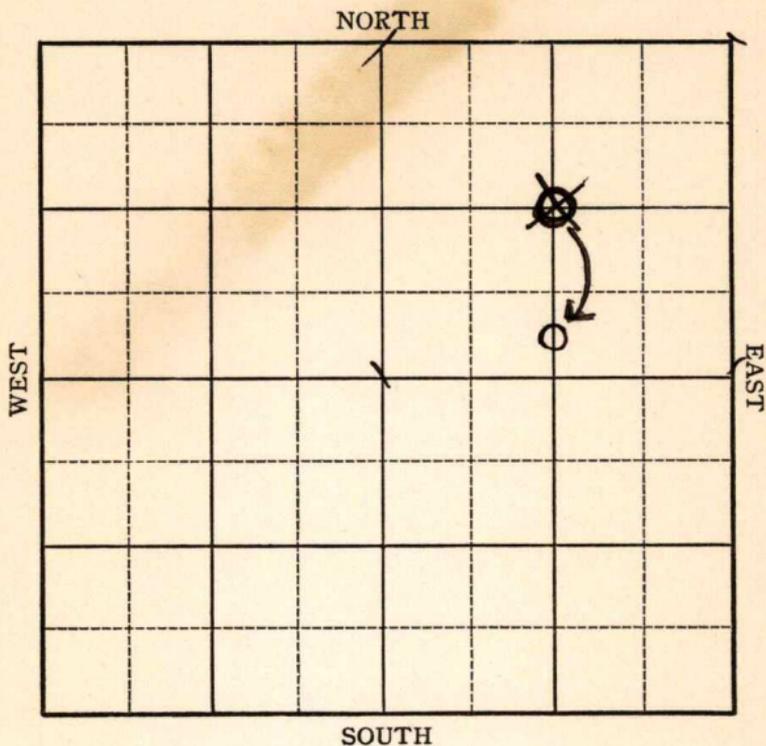

Sec. 22 Twp. 33 R. 13-WWell No. #1 B.E. Holmes "B" FarmBarbata Oil Company~~1320~~ Ft. from N. Line330 Ft. from S. Line1320 Ft. from E. Line

\_\_\_\_\_ Ft. from W. Line

Elev. 1659

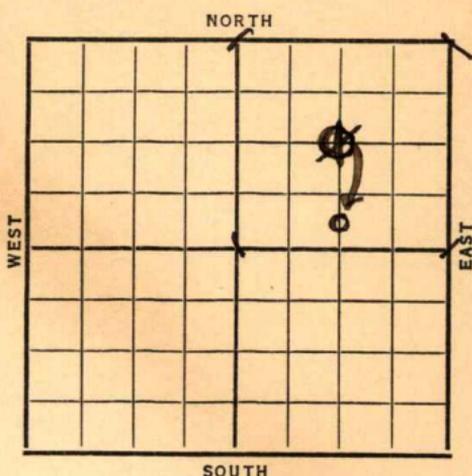

Date	REPORT
1937	
9/15	Cellar
9/24	B. Rot.
10/2	S. H.
10/8	13" @ 279'. Drlg. 1150'.
10/15	Drlg. 2500'.
10/22	Drlg. 3360'.
10/29	Drlg. 4125'.
11/5	K.C. 3990'. Drlg. 4400'.
	No shows.
11/12	Chat 4510'. 7" @ 4530'. WOC.
	No shows.
11/19	Drlg. 4575'.b
11/26	Fsg. 4785'.
12/3	" "
12/10	Drlg. 4840'.
12/17	Viola 4914'. T.D. 4930'.
	No shows. P.B. 4640'.
	Shot 120 qts. Est $\frac{1}{2}$ M gas.
12/24	P.B. 4640'. Est. $\frac{1}{2}$ M gas.
12/31	P.B. 4640' SD.

OVER

1938

1/5

7" @ 4530'.

Viola 4914'.

T.D. 4930'.

P.B. 4640'.

120 qts. 4605-38'.

1 $\frac{3}{4}$  M gas.

COMPLETED

*Barber* KANSAS

Map No. 93 Sec. 22 Twp. 33 R. 13<sup>W</sup>


Well No. 1-B. E. Holmes "B"

Barbara Oil Company

Contractor

FIRST REPORT

SECTION PLAT

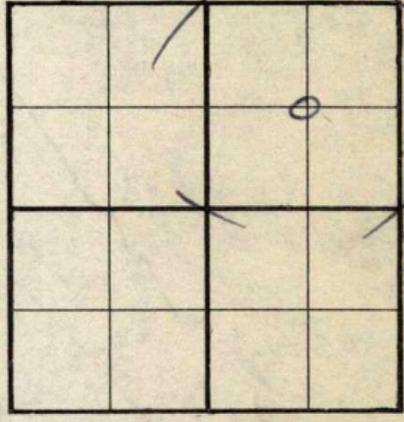

1320 Ft. from N. Line

\_\_\_\_\_ Ft. from S. Line

1320 Ft. from E. Line

\_\_\_\_\_ Ft. from W. Line

Location \_\_\_\_\_

Rig up \_\_\_\_\_

Drilling and Remarks:

*Cellar*

RECORD

Cased \_\_\_\_\_ in., \_\_\_\_\_ ft.

Sand \_\_\_\_\_

Gas \_\_\_\_\_

Oil \_\_\_\_\_

Total Depth \_\_\_\_\_

PRODUCTION

1st 24 hrs. Nat. \_\_\_\_\_

1st 24 hrs. after shot \_\_\_\_\_

Gas \_\_\_\_\_ Cu. Ft.

Dry Hole \_\_\_\_\_

Abandoned \_\_\_\_\_

Date

SEP 15 1937 19

H. D. Hatfield Scout

*Barber* **KANSAS**

Map No. 93 Sec. 22 Twp. 33 R. 13W

Well No. 1-B E Holmes "B"

Barbara Oil Company

Contractor

**CORRECTION**

C S L N E

\_\_\_\_\_ Ft. from N. Line

330 Ft. from S. Line

1320 Ft. from E. Line

\_\_\_\_\_ Ft. from W. Line

**SECTION PLAT**

			0 ↘ 0

Location \_\_\_\_\_

Rig up \_\_\_\_\_

Drilling and Remarks:

*first reported as C NE - has been corrected to C S L N E*

**RECORD**

Cased \_\_\_\_\_ in., \_\_\_\_\_ ft.

Sand \_\_\_\_\_

Gas \_\_\_\_\_

Oil \_\_\_\_\_

Total Depth \_\_\_\_\_

**PRODUCTION**

1st 24 hrs. Nat. \_\_\_\_\_

1st 24 hrs. after shot \_\_\_\_\_

Gas \_\_\_\_\_ Cu. Ft.

Dry Hole \_\_\_\_\_

Abandoned \_\_\_\_\_

Date

**NOV 17 1937**

19

**H. D. Hatfield**

Scout

