


Section 13 Township 33 Range 40-W

Well No. #1-13 Hayward

Company Panhandle Eastern

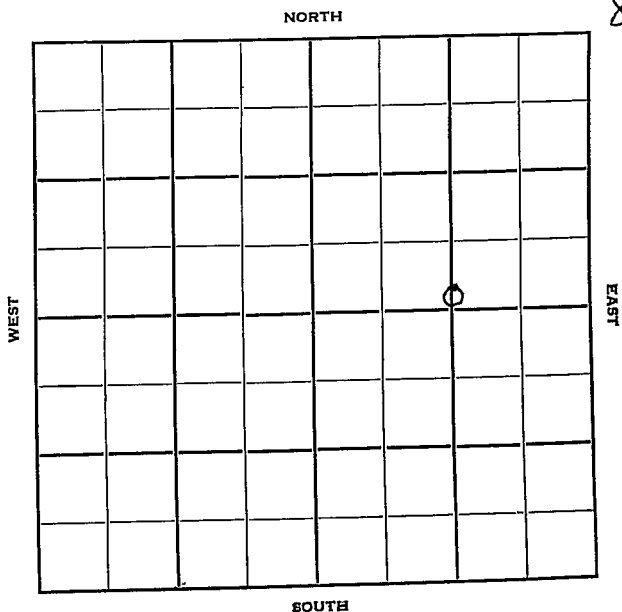

KANSAS

Morton

Sec. 13 Twp. 33 R. 40-W ✓

Well No. #1-13 Hayward Farm

Panhandle Eastern Company

Hugoton Contractor


 Ft. from N. Line

150 Ft. from S. Line

1320 Ft. from E. Line

 Ft. from W. Line

C S L NE/4

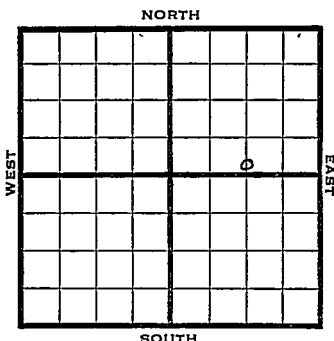

1950

Elev 3265

REPORT

7/19

Spud 7-15-50

10" @ 533

WOC

8/16

10" @ 533

7" @ 2393

TD 2595

Her 2395

Krider 2492

Win 2490

Comp 2,856,000 gas

Completed

COMPLETED

Kansas


Map No. _____ Sec. 13 Twp. 33 R. 40WWell No. 1-13 HaywardPanhandle Eastern

Company

Contractor

C S L NE/4

SECTION PLAT

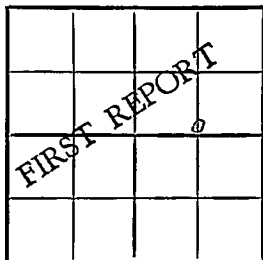

_____ Ft. from N. Line

1500 Ft. from S. Line1320 Ft. from E. Line

_____ Ft. from W. Line

Morton County

Location _____

Rig up _____

Drilling and Remarks:

Spud 7-15-50

10" @ 533

WOC

RECORD

Cased _____ in., _____ ft.

Sand _____

Gas _____

Oil _____

Total Depth _____

PRODUCTION

1st 24 hrs. Nat. _____

1st 24 hrs. after shot _____

Gas _____ Cu. Ft.

Dry Hole _____

Abandoned _____


Date

JUL 19 1950.

19

J. E. TYRA

Scout

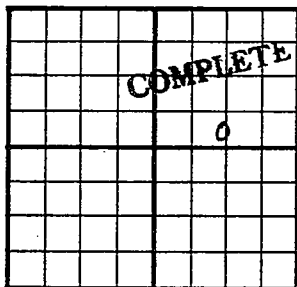County Morton State KansasSec. 13 (^{Blk.}
Twp.) 33 (^{Sur.}
Rge.) 4 OW Map No.Operator Panhandle EasternWell No. 1-13 Farm HaywardElev. 3265 Location C S L. NE/4150 Ft. From S Line NE1320 Ft. From E Line Quarter1st. ReportCompletion AUG 16 1950RemarksSpudding Date 7-15-50Drlg. Data Gas well TD 259510" @ 533 7" @ 2393 TD 2595Her. 2395 Krider 2492 Win. 2490Comp. 2,856,000 gas

J. E. TYRA