


Barber

KANSAS

SECTION 9 TOWNSHIP 33S RANGE 14W

WELL NO. #1 McGrath "B"

COMPANY Petroleum Inc.

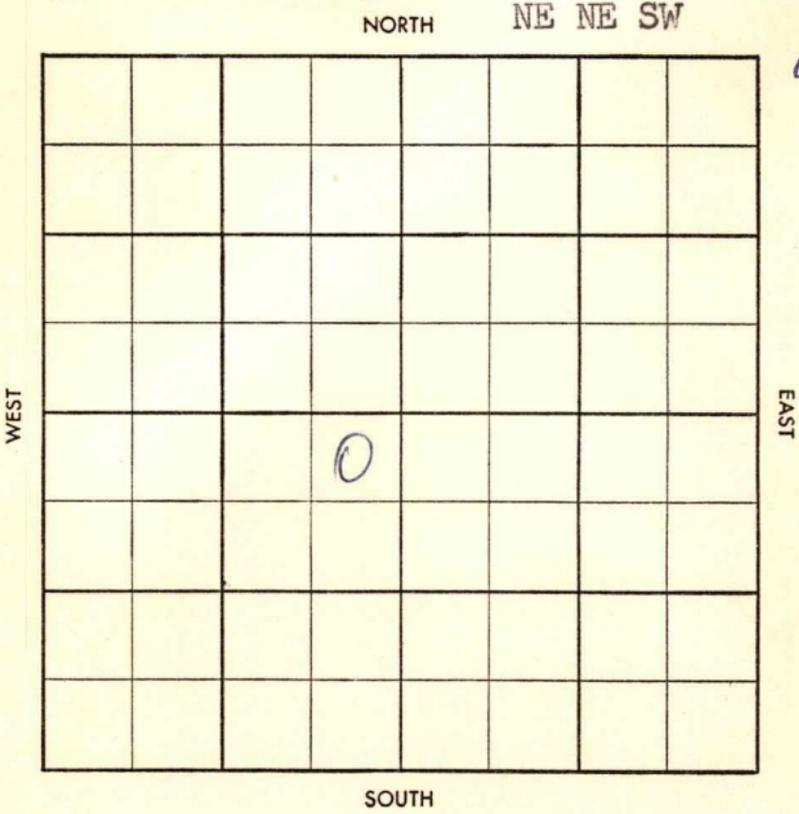

Twp. ~~Medicine Lodge~~ Pool ~~Medicine Lodge~~
 Co. ~~Facet~~

S-513-B

County Barber Elev. 1760 DF
 Sec. 9 Twp. 33 Rge. 14W
 Company Petroleum Inc.
 Farm Name McGrath "B" No. 1

TOPS	DEPTH	LOG	DATUM
Anh <u>Elgin</u>	<u>3745</u>		
Tp.	<u>3906</u>		
H.			
Tr.			
Dg. <u>3 1/2</u>	<u>3943</u>		
Bot <u>Dg 3 1/2</u>	<u>4068</u>		
L.	<u>4103</u>		
K.C.			
B.K.C.	<u>4527</u>		
Ce.			
C.			
M. <u>Chart</u>	<u>4648</u>		
M. <u>Li</u>	<u>4682</u>		
K.			
Mz.			
Mq.			
V.			
S.			
S.			
A.			
R.			
Pf.			
G.			
T.D.	<u>4735</u>		

Loc. in Sec. N 1/2 SW
 Geol. _____
 Contr. _____
 Pool W.C.
Medicine Lodge

COMPLETE
 0
 MAY 14 '58

Date Comm. 3-7-58 CSO - FO
8" @ 1057/500 drlg. 2035 MAR 19 '58
~~8" @ 1057/500~~ DST 4651-73 of 60" g 1/3"
 ga 1.450 met 160" res 115' 506
 Hgen 20' W BHP 1560/30" DST
 4673-84 of 60" 1080' gip
 res 60' g 6 20cm 30' MW +
 60' W BHP 1260/30" Log
 4 1/2" APR 2 '58 4732/125 APR 9 '58 CO
 4687 28/4652-66 ga 400 met
 ga 416 met base 15x15

2.088 mcf + Ld APR 16 '58

) APR 23 '58

APR 30 '58

2087 mcf

+ load 7cf 750 MAY 7 '58

gas

1. 461 mcf FCP 520 SI

gas cost \$4.491 mcf SIP 1630-

1370 Dry

9-33-14W

NENE SW

26

County Barber Elev. _____
 Sec. 9 Twp. 33 Rge. 1/1W
 Company Petroleum Inc.
 Farm Name McGrath "B" No. 1

TOPS	DEPTH	LOG	DATUM	Loc. in Sec.
Anh. _____				<u>NE NE SW</u>
Tp. _____				
H. _____				
Tr. _____				
Dg. _____				
B.L. _____				Geol. _____
L. _____				Contr. _____
K.C. _____				
B.K.C. _____				Pool _____
Ce. _____				
C. _____				
M. _____				
M. _____				
K. _____				
Mz. _____				
Mq. _____				
V. _____				
S. _____				
S. _____				
A. _____				
R. _____				
Pf. _____				
G. _____				
T.D. _____				

MAR 12 58
 FIRST REPORT

Date Comm. 3-7-58 CSO - FO
8" @ 1057/500 drlg. 2035