

KANSAS

Sec. 12 Twp. 33 R. 14-W

Well No. #1 Storm Farm

Champlin Ref. Company

Wildcat


 Ft. from N. Line

990 Ft. from S. Line

330 Ft. from E. Line

 Ft. from W. Line

NE SE NE

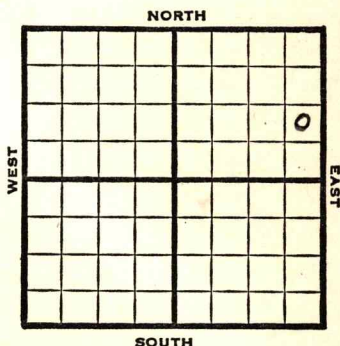

1947

El. 1908'

REPORT

6/11 Location

6/17 10" @ 400'
Drlg. 2224'

6/24 Drlg. 3205'

7/1 Drlg 4120'

7/8 Mississippi 4716'
Drlg. 4765'

7/16 Mag. 5036'
Drlg 5130'

7/23 Mag. 5036'
Simp. 5175'
Arb. 5288'
T.D. 5332'
Abandoned

ABANDONED

Map No. _____ Sec. 12 Twp. 33 R. 14W

Well No. 1 Storm

Champlin Ref.


Company

FIRST REPORT

Contractor

NE SE NE

SECTION PLAT

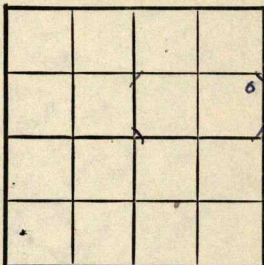

_____ Ft. from N. Line

990

_____ Ft. from S. Line

330

_____ Ft. from E. Line

_____ Ft. from W. Line

Barber County

Location X

Rig up _____

Drilling and Remarks:

RECORD

Cased _____ in., _____ ft.

Sand _____

Gas _____

Oil _____

Total Depth _____

PRODUCTION

1st 24 hrs. Nat. _____

1st 24 hrs. after shot _____

Gas _____ Cu. Ft.

Dry Hole _____

Abandoned _____

Date

JUN 1 1 1947

19

S. J. LEWIS

Scout

Kansas

Map No. 93 Sec. 12 Twp. 33 R. 14WWell No. 1 Storm

Champlin Ref.

Company

~~ABANDONED~~

Contractor

NE SE NE

E. 1, 1908
SECTION PLAT

			4

 Ft. from N. Line990 Ft. from S. Line330 Ft. from E. Line Ft. from W. Line

Barber County

Location Rig up

Drilling and Remarks:

Magneto 5226
Single 5770
Car 45-258

RECORD

Cased in., ft.Sand Gas Oil Total Depth 5782

PRODUCTION

1st 24 hrs. Nat. 1st 24 hrs. after shot Gas Cu. Ft.Dry Hole Abandoned

Date

JUL 23 1947

S. J. LEWIS

19

Scout