


DX 78-1 Barber

KANSAS

Section 16 Township 33 Range 11W

Well No. #1 McGrath "A"

Company Musgrove Pet

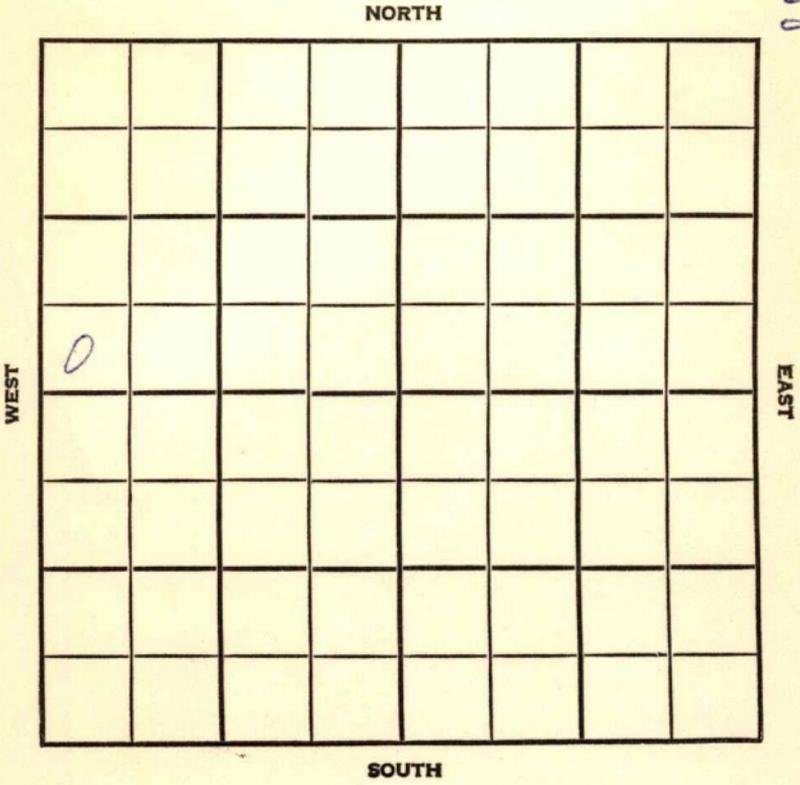


SEC. 16	TWP. 33	R. 14W
------------	------------	-----------

WELL NO. #1 McGrath FARM COMPANY

Musgrove Petr. CONTRACTOR Rupp-Ferguson

_____ Ft. from N. Line
 _____ Ft. from S. Line
 _____ Ft. from E. Line
 _____ Ft. from W. Line

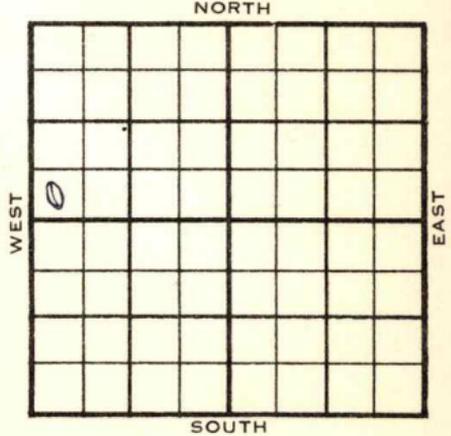

SW SW NW

Shell- DHM

1956	ELEVATION	REPORT
	1709'	
3-21	Location	
5-29	Comm. 3-24-56 8 5/8" @ 410 2/400 Lost hole @ 1280 Skid rig 30' West 13 3/8" @ 290 8 5/8" @ 1145 DST 3922-51 op 40 min. rec. 290' sgcsw, 1380/15" DST 4632-62 op 20 min, gas in 1 min. 10,400 mcfg in 5 min, rec. 2' dist. 1815#. DST 4667-80 op 1/2 hr. rec. 5' mud, 0#. 5 1/2" @ 4870/275 112/4639-67, 9,100 mcfg, 250 A Frac, 20 mcfg, est cap. 50 mil cfg, Comp. SI gas well, 8 million cfg. Tarkio 3117', H. 3855', Tr. 3869', Dg. sd. 3919', L. 4073', Marm 4502', M. Chert 4642'. Log tops: H. 3874', Tr. 3892', ### Dg. sd. 3911', L. 4076', Marm 4505', M. Chert 4638', K. 4894', V. 4953', S. 5099', A. 5210'. TD 5230'	

OVER COMPLETED

1956

7-25 ADDITIONAL INFORMATION:

Pfs. 4639-67 Ga: 734 MCFGPD

Pfs. 72/4702-20 32/4682-90 500 Acid

Swb $2\frac{1}{2}$ BXWPH for 8 hrs. no sho oil ~~for~~
or gas;

From pfs. 4639-90 ga; 500 MCFGPD:

PB 4619

Pf 28/4594-4601, gas to surf. 2 min,

ga; 500 mcfg. \neq $2\frac{1}{2}$ bxwph; PB 4564;

Pf 32/4524-32, no sho- 500 acid-no sho
D & A

ABANDONED

ADDITIONAL INFORMATION

County Barber Elev. _____
 Sec. 16 Twp. 33S Rge. 14W
 Company Musgrove Pet.
 Farm Name McGrath "A" No. 1

TOPS	DEPTH	LOG	DATUM	Loc. in Sec.
Anh.				SW SW NW
Tr.				
H.				
Tr.				
Dg.				
Bl.				
L.				Geol. _____
K.C.				Contr. _____
B.K.C.				
Ce.				
C.				
M.				
M.				Pool _____
K.				
Mz.				
Me.				
V.				
S.				
S.				
A				
R.				
PC.				
G.				
T.D.				

JUL	2	5	1956

~~FIRST REPORT~~

Date Comm. _____ ADDITIONAL INFORMATION
 Pfs. 4639-67 Ga: 734 Mcfgpd
 Pfs. 72/4702-20 32/4682-90 500 Acid
 Swb 2 1/2 bxxwh for 8 hrs. - no sho oil or gas
 From pfs. 4639-90 ga: 500 Mcfgpd; PB 4619
 Pf 28/4594-4601, gas to surf. 2" Ga: 500
 Mcfg. 2 1/2 bxxwh; PB 4564; Pf. 32/4524-32
 no sho - 500 Acid - no sho

D & A Comp.

Co.
Lse.
No.
Sec.
T.
R.

County Barber Elev. _____
 Sec. 16 Twp. 33 Rge. 14W
 Company Musgrove Pet.
 Farm Name McGrath No. 1

TOPS	DEPTH	LOG	DATUM	Loc. in Sec.
Anh.				SW SW NW
Tp.				
H.				
Tr.				
Dg.				
Bl.				
L.				Geol. _____
K.C.				Contr. _____
B.K.C.				<u>Rupp-Ferguson</u>
Ce.				
C.				Pool _____
M.				
M.				
K.				
Mz.				
Mq.				
V.				
S.				
S.				
A.				
R.				
Pe.				
G.				
T.D.				

FIRST REPORT
 MAR 21 '56

Date Comm. _____ Shell - DHM
 Location _____

28

Co.
 No.
 Sec.
 T.
 R.

County Barber Elev. 1709
 Sec. 16 Twp. 33 Rge. 14W
 Company Musgrove Pet.
 Farm Name McGrath No. 1

	TOPS	DEPTH	LOG	DATUM
Anh.				
Tp.	<u>Tarkio</u>	<u>3117</u>		<u>1408</u>
H.		<u>3855</u>	<u>3874</u>	<u>2165</u>
Tr.		<u>3869</u>	<u>3892</u>	<u>2183</u>
Dg.	<u>sd</u>	<u>3919</u>	<u>3911</u>	<u>2202</u>
Bl.				
L.		<u>4073</u>	<u>4076</u>	<u>2367</u>
K.C.				
B.K.C.	<u>Mason</u>	<u>4502</u>	<u>4505</u>	<u>2796</u>
Ce.				
C.				
M.	<u>Chert</u>	<u>4642</u>	<u>4638</u>	<u>2929</u>
M.				
K.			<u>4894</u>	<u>3185</u>
Mz.				
Me.				
V.			<u>4953</u>	<u>3244</u>
S.			<u>5099</u>	<u>3390</u>
S.				
A.			<u>5210</u>	<u>3501</u>
R.				
Pe.				
G.				
T.D.		<u>5230</u>		

Loc. in Sec. SW SW NW
 Geol. _____
 Contr. Rupp-Ferguson
 Pool _____

o			

COMPLETE

Date Comm. 3-24-56 MAY 29 1956
 8 5/8" @ 410/400 lost hole @ 1280
 skid rig 30' west 13 3/8" @ 290
 8 5/8" @ 1145 DST 3922-51 open 40 min.
 rec. 290' sgcsw 1380/15" DST 4632-62
 open 20 min. gas in 1 min.
 10,400 mcfg in 5 min. rec. 2' dist.
 1815# DST 4667-80 open 1/2 hr.
 rec. 5' mud 30# 5 1/2" @ 4870/275

OVER

112/ 4639-67 9,100 mcfg 250 A
frac 20 mcfg est cap. 50 mil cfg
Comp. SI gas well 8 million cfg

R. G.

JUN 7 1956