


DX 78-1

Barber **KANSAS**

Section 24 Township 33 Range 14<sup>W</sup>  
Well No. 1 Baier "B"  
Company Lion Oil

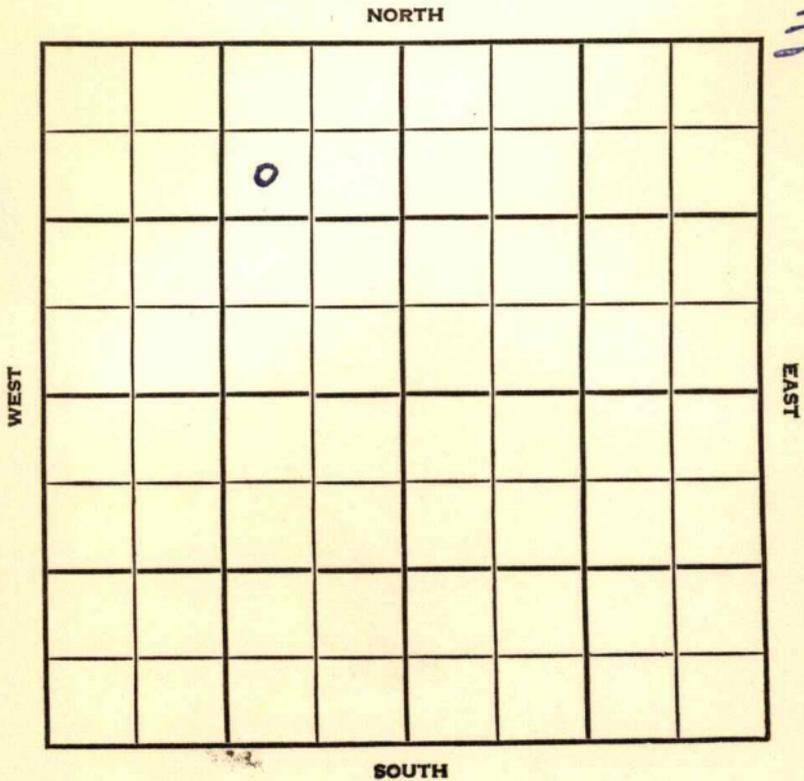




County Barber State Kansas

Sec. 24 (Blk. 33) (Sur. 14W) (Twp.) Map No.

Operator Lion Oil

Well No. 1 Farm Baier "B"

Elev. Location SW NE NW

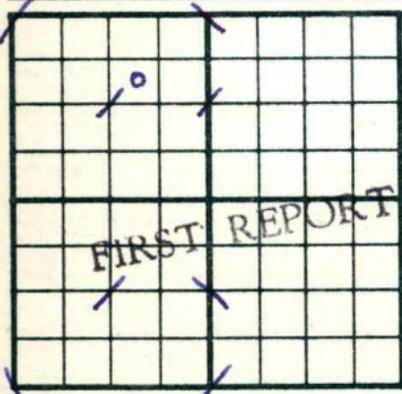

990 Ft. From N Line NW

990 Ft. From E Line Quarter

1st. Report MAR 23 1955

Completion

Remarks

G-M-R Contr.

Spudding Date

Drlg. Data Medicine Lodge Pool

Location

FABEN GILSTRAP